


Section 12 Township 31 Range 33WWell No. #1 P L MillerCompany Warren Pet.
Hugoton Pool

NORTH

WEST

EAST

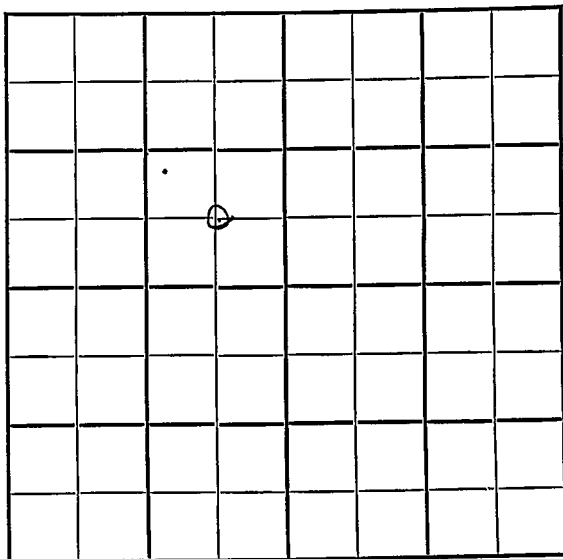

SOUTH

Sec. 12 KANSAS Twp. 31 R. 33W

Well No. #1 P. L. Miller Farm

Warren Pet. Company

Houghton Pool

NORTH


 Ft. from N. Line

660 Ft. from S. Line

660 Ft. from E. Line

 Ft. from W. Line

C SE NW

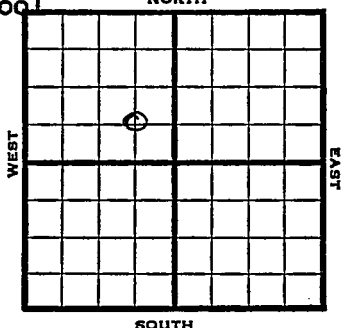

1948	Elev. 2886' REPORT
4/21	Location
4/28	"
5/5	RUR
5/12	10" @ 602' Drlg. 2570'
5/19	TD 2600' 7" @ 2597'
5/26	TD 2702' -119000 acid.
6/1	"
6/9	7" @ 2597' 11,000 acid 4,500,000 gas 420# R. Pr. TD 2702' Comp.
COMPLETED	

Map No. _____ Sec. 12 Twp. 31 R. 33WWell No. 1 P. L. MillerWarren Pet. _____ CompanyFIRST REPORT _____ Contractor

C SE NW

SECTION PLAT

	a		

_____ Ft. from N. Line

660 _____ Ft. from S. Line660 _____ Ft. from E. Line

_____ Ft. from W. Line

Seward CountyLocation X _____

Rig up _____

Drilling and Remarks:

RECORD

Cased _____ in., _____ ft.

Sand _____

Gas _____

Oil _____

Total Depth _____

PRODUCTION

1st 24 hrs. Nat. _____

1st 24 hrs. after shot _____

Gas _____ Cu. Ft.

Dry Hole _____

Abandoned _____

Date

APR 21 1948 19 S. J. LEWIS Scout

Map No. _____ Sec. 12 Twp. 31 R. 33W

Well No. 1 P. L. Milher

Warren Pet.

Company

COMPLETE

Contractor

C SE NW

27,2876
SECTION PLAT

	Δ		

_____ Ft. from N. Line

660 Ft. from S. Line

660 Ft. from E. Line

_____ Ft. from W. Line

Seward County

Location _____

Rig up _____

Drilling and Remarks:

2' C2592

11000 acid

4,500,000 Gals

425 R/R

RECORD

Cased _____ in., _____ ft.

Sand _____

Gas _____

Oil _____

Total Depth 2702

PRODUCTION

1st 24 hrs. Nat. _____

1st 24 hrs. after shot _____

Gas _____ Cu. Ft.

Dry Hole _____

Abandoned _____

Date

JUN 9 1948

19

S. J. LEWIS

Scout