

Section 12 Township 31 Range 21-WWell No. 1 Barryman & BriggsCompany Huber et al

Wildcat

NORTH

				*			0


SOUTH

CLARK
Ford

Sec. 12 Twp. 31 R. 21-W
Well No. 1 Burryman & Driggs Farm
Huber et al Company

Wildcat

 Ft. from N. Line
330
 Ft. from S. Line
330
 Ft. from E. Line
 Ft. from W. Line
SE/C

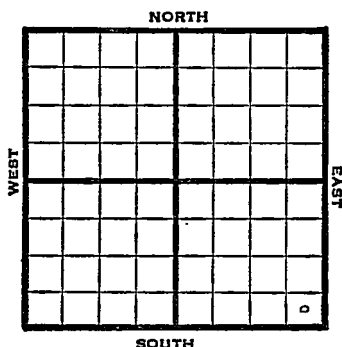

1947	REPORT
8/13	Loc.
8/20	RUR
8/27	"
9/3	10" @ 400' 1320 Lost Circulation
9/10	Lost hole 1322' skid rig 100' north Drlg. 480'
9/17	16" @ 207' Anhydrite 1160' 10" @ 1315' Drlg. 1980'
9/24	Drlg. 3465'
10/1	Holenberg 2480' Herrington 2530' Ft Riley 2710' Heebner 4286' Brown Lime 4477' Lansing 4496' Drlg. 4785'
10/8	Mississippi 5210' TD 5310' DST 5214-60 open 1/2 hr Rec Mud
	OVER

1947

10/15

Miss 5210

TD 5310'

ABANDONED

Kansas

Map No. 95 Sec. 12 Twp. 31 R. 21WWell No. 1 Burryman & BriggsHuber et al.

Company

CORRECTION

Contractor

SE/C

SECTION PLAT

			o

 Ft. from N. Line330 Ft. from S. Line330 Ft. from E. Line Ft. from W. Line

Clark County

Location Rig up

Drilling and Remarks:

Reported it
in Ford County

RECORD

Cased in., ft.Sand Gas Oil Total Depth

PRODUCTION

1st 24 hrs. Nat. 1st 24 hrs. after shot Gas Cu. Ft.Dry Hole Abandoned

Date

AUG 13 1947

19

S. J. LEWIS

Scout

Wm

Misc. Small Maps

Cards

Tracing

France Map

Scarborough Map

Pierce Map

Geological Dept.

Pierce Plat Book

Map No. _____ Sec. 12 Twp. 31 R. 21W

Well No. 1 Burryman & Briggs

Huber et al. Company

FIRST REPORT Contractor

SE/C


SECTION PLAT

_____ Ft. from N. Line

330 Ft. from S. Line

330 Ft. from E. Line

_____ Ft. from W. Line

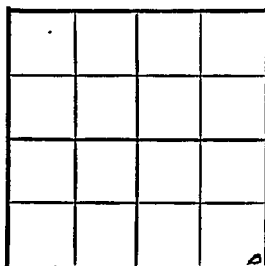

Clark

Clark County

Location X

Rig up _____

Drilling and Remarks:

RECORD

Cased _____ in., _____ ft.

Sand _____

Gas _____

Oil _____

Total Depth _____

PRODUCTION

1st 24 hrs. Nat. _____

1st 24 hrs. after shot _____

Gas _____ Cu. Ft.

Dry Hole _____

Abandoned _____

Date

AUG 13 1947

19

S. J. LEWIS

Scout

W m p

Misc. Small Maps	
Cards	<i>W m p</i>
Tracings	
France Map	
Scarborough Map	
Pierce Map	
Geological Dept.	
Pierce Plat Book	

Map No. 95 Sec. 12 Twp. 31 R. 21W

Well No. 1 Berryman & Briggs

Huber et al. Company


ABANDONED

Contractor

SE/C

5/1, 2/85

SECTION PLAT

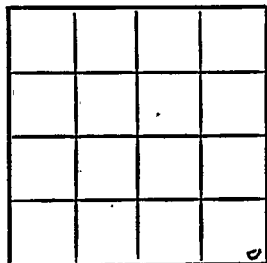

 Ft. from N. Line

330 Ft. from S. Line

330 Ft. from E. Line

 Ft. from W. Line

Clark County

Location

Rig up

Drilling and Remarks:

Mis 5210

RECORD

Cased in., ft.

Sand

Gas

Oil

Total Depth 5310

PRODUCTION

1st 24 hrs. Nat.

1st 24 hrs. after shot

Gas Cu. Ft.

Dry Hole

Abandoned

Date

OCT 15 1947

19

S. J. LEWIS

Scout

Misc. Small Maps







