


Section 12 Township 31 Range 15W

Well No. 1 Riepe

Company Cities Service

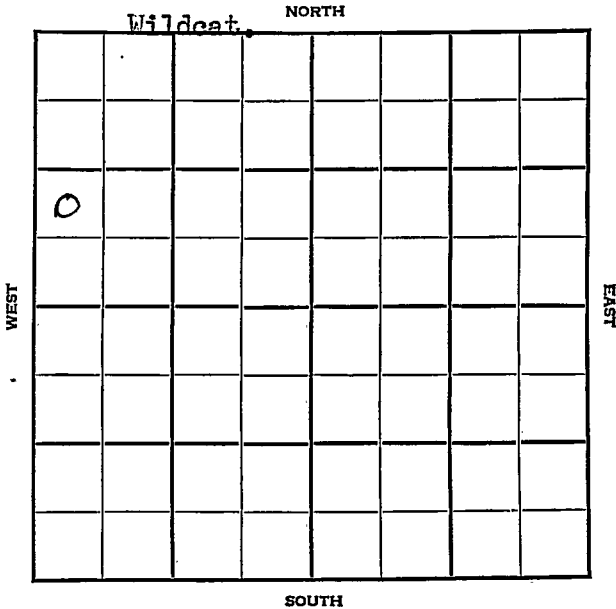

KANSAS

Barber

Sec. 12 Twp. 31 R. 15-W

Well No. #1 Riepe Farm

Cities Service Company

Wildcat


Ft. from N. Line

990' Ft. from S. Line

Ft. from E. Line

330' Ft. from W. Line

NW SW NW

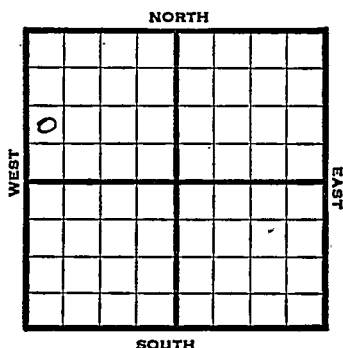

1947 Elev. 1737' REPORT

11/12	Location
11/19	Drlg. 730'
11/25	8" @ 833' Drlg. 3225'
12/3	Lansing 3851' Drlg. 4400'
12/10	Mississippi 4424 Viola 4480 Simpson 4670 Drlg. 4747'
12/17	Arbuckle 4747' TD 4808' PB 4632' 5" @ 4632' RUST
12/30	103 shots 4538-62' - 1½ ??? W in 3¼ hrs. 1000 acid Swb. 33 W 12 hrs.
1948	
1/7	64 shots. 4511-30 3 gals. water PH 1000 acid.
1/14	Arb. 4747' 5" @ 4632' TD 4808'

ABANDONED

Map No. _____ Sec. 12 Twp. 31 R. 15W

Well No. 1 Riepe

Cities Service

Company

FIRST REPORT

Contractor

NW SW NW

SECTION PLAT

_____ Ft. from N. Line


990

_____ Ft. from S. Line

_____ Ft. from E. Line

330

_____ Ft. from W. Line

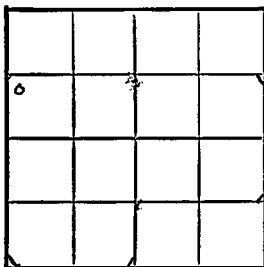

Barber County

Location X

Rig up _____

Drilling and Remarks:

RECORD

Cased _____ in., _____ ft.

Sand _____

Gas _____

Oil _____

Total Depth _____

PRODUCTION

1st 24 hrs. Nat. _____

1st 24 hrs. after shot _____

Gas _____ Cu. Ft.

Dry Hole _____

Abandoned _____

Date

NOV 1 2 1947

19

S. J. LEWIS

Scout

Map No. 93 Sec. 12 Twp. 31 R. 15W

Well No. 1 Riepe

Cities Service Company

ABANDONED

Contractor

NW SW NW

E11737

SECTION PLAT

o			

Ft. from N. Line

990 Ft. from S. Line

Ft. from E. Line

330 Ft. from W. Line

Barber County

Location _____

Rig up _____

Drilling and Remarks:

Cor 84747
5' @ 4632

RECORD

Cased _____ in., _____ ft.

Sand _____

Gas _____

Oil _____

Total Depth *4508* ✓

PRODUCTION

1st 24 hrs. Nat. _____

1st 24 hrs. after shot _____

Gas _____ Cu. Ft.

Dry Hole _____

Abandoned _____

Date

JAN 14 1948 19

S. J. LEWIS Scout