Sumner


KANSAS

SECTION 12 TOWNSHIP 31S RANGE 2W

WELL NO. #1 Nyberg

COMPANY Beardmore Drlg.

NE NE NE

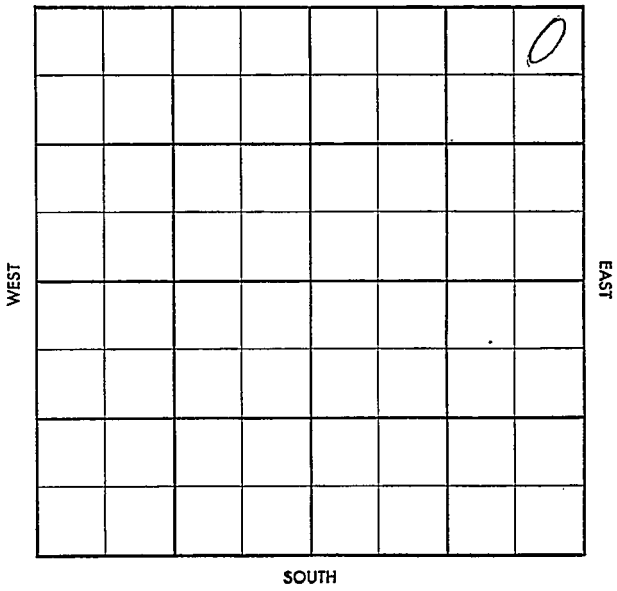

FORM 504-3 SUNRAY

WILDCAT

S-513-A

CO. Sumner ELEV.

SEC. 12 TWP. 31 RGE. 2W

COMPANY Beardmore Drlg NO. 1

FARM Nyberg

LOC. NE NE NE

GEOL.

CONTR. Co. Tools

POOL Wildcat

SPUD

Location

CO.
LSE.
NO.
SEC.
TWP.
RGE.

S-513-A

CO. Sumner ELEV. 1287 DF JAN 15 '58

SEC. 12 TWP. 31 RGE. 2W

COMPANY Beardmore Drl. NO. 1 COMPLETE

FARM Kyberg Pan Am Skelly DHC

LOC. NE NE NE

GEOL.

CONTR. Co. Tools

POOL Wildcat

SPUD 11-21-57

Location

8" 219/130

Ø/100 DEC 57 KC

3049 Mclust

3713 Mdol/3717

TD 4182 DST 3717-23

60" 60' 0 g cm + 60' HO g cm

FP 30-45 BHP 1435-1015

cnd 3723-33 rec 10' DST

3720-33 60" g/6" TSTM

90' 0 g cm FP 20-30

BHP 1470-1350/20" cnd

3733-43 rec 10'

10' Li. dol ~~good~~ no

DST 3730-43 60" g/8"

60' 0 g cm + 120' VHO gc

M + 100 MO + 20'W FP

30-115 BHP 1300/20"

cnd 3743-54 rec 11'

DST 3744-54 60" g/12"

rec 60' 0 g cm + 60 VHO

+ g cm + 30 OM · 100 MO

20'W FP 75-175 BHP

1370/20" 5 Sd 4174 RTD

4182 5½" 3785/15 WOCT

8% CO 84/3738-52 & 2 BOPH

+ ½ BWPH 7 hrs 300A testing

DEC 28 '57 & 5 BFPH ⅓ W ~~OSP~~

rec 200 B new oil ~~OSP~~

JAN 2 '58 JAN 3 '58 JAN 15 '58

PI+P 55 BOPD + 35 BW

43.5° gr