
Harper Kansas

DX 78-1

Section 12 Township 31 Range 9W

Well No. 1 Fred Grabe

Company Magnolia Pet.

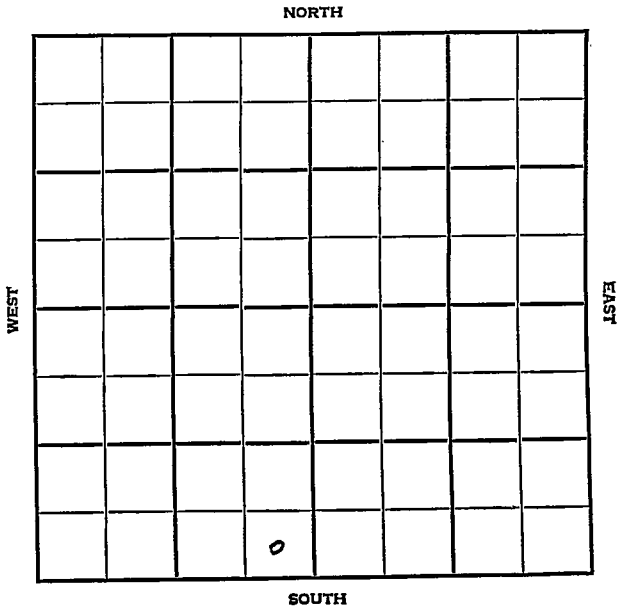

Harper KANSAS

SEC.	TWP.	R.
12	31	9 W

WELL NO. # 1 Fred Grabs FARM

COMPANY Magnolia Pet.

CONTRACTOR Bass


_____ Ft. from N. Line

330 Ft. from S. Line

330 Ft. from E. Line

_____ Ft. from W. Line

SE SE SW

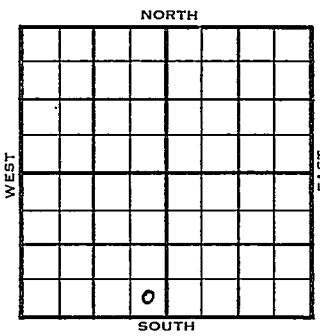

ELEVATION 1631'

REPORT

1954

5/26 Location

6/2 "

6/9 "

6/23 10" @ 234 Lans 3638
Drlg. 4175'

9/22 Spud 6-9-54
Oil Well
TD 4500'
10" @ 234'
Lans 3638', Miss 4374'
DST 4376-93', opn 1 hr., rec. 45' sgcm, 1180#
DST 4408-30, opn 1 hr., rec. 20' mud, SSO 41#
DST 4434-50', opn 1 hr., rec. 5' ho& gcm, 165' O&GCM, 10' wtr, 860#
TD 4500'
7" @ 4498'
CO to 4458'
60/4434-44, S/10 bwph 2 hrs., 4 bswph 4 hrs.
CO to 4440
20/4434-49, 1 gwph 12hrs.
Sd-frac, F/3 bo 970,000 cfg 2 hrs.
F/13 bo 11 bsw 24 hrs., F/10 bo 8 bwph
Comp. F/5 bopd 50% wtr.

DX-78

COMPLETED

FORM 275 FOR SALE BY KANSAS BLUE PRINT CO.


County Harper State Kansas

Sec. 12 (Blk.. Twp.) 31 (Sur. Rge.) 9W Map No.

Operator Magnolia Pet.

Well No. 1 Farm Fred Grabs

Elev. Location SE SE SW

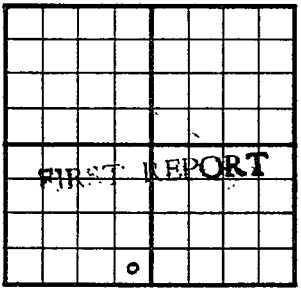

330 Ft. From S Line SW

330 Ft. From E Line Quarter

1st. Report MAY 26 1954

Completion

Remarks

Bass - Contr.

Spudding Date

Drlg. Data

Location

J. G. McGEHEE

FORM 275 FOR SALE BY KANSAS BLUE PRINT CO.


County Harper State Kansas

Sec. 12 (Blk. Twp.) 31 (Sur. Rge.) 9W Map No.

Operator Magnolia Pet.

Well No. 1 Farm Fred Grabs

Elev. 1631 Location SE SE SW

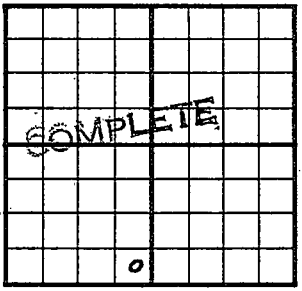

330 Ft. From S Line SW

330 Ft. From E Line Quarter

1st. Report May 26 1954

Completion SEP 2 2 1954

Remarks

Bass - Contr.

Spudding Date 6-9-54

Drlg. Data Oil well TD 4500

10" @ 234 Lans. 3638 Miss. 4374

DST 4376-93 open 1 hr. Rec. 45' sgcm

1180# DST 4408-30 open 1 hr.

Rec. 20' mud SSO 41# DST 4434-50

open 1 hr. Rec. 5' ho & gcm 165' o & gcm

10' wtr. 860# TD 4500 7" @ 4498

CO to 4458 60/ 4434-44 S/ 10 bwph

2 hr. 4 bswph 4 hr. CO to 4440

20/ 4434-39 1 gwph 12 hr. sd-frac

F/ 3 bo 970,000 cfg 2 hr. F/ 13 bo

11 bsw 24 hr. F/ 10 bo 8 bwpd

Comp. F/ 5 bopd 50% wtr.

FABEN GILSTRAP