

Section 12 Township 31 Range 9WWell No. #1 MuirCompany Beardmore Drlg.

NORTH

							0

WEST

EAST

SOUTH

Harper

KANSAS

Sec. 12 Twp. 31 R. 9 W

Well No. # 1 Muir Farm

Beardmore Drlg. Company

Beardmore Drlg. Contractor

Ft. from N. Line

990


Ft. from S. Line

330

Ft. from E. Line

Ft. from W. Line

NE SE SE

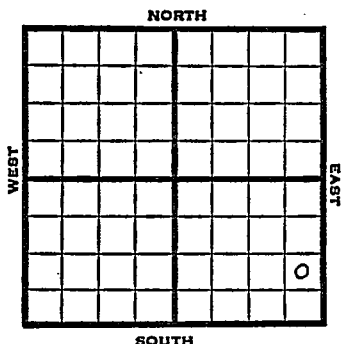

1951

Elev. 1666' REPORT

4/25

Location

6/27

Spud 4-28-51

Oil well TD 4448' 8" @ 180'

Miss 4418'

DST 4419-23' open 1 hr, rec 18' mud,

5" @ 4427' TD 4448' 3/4 BOPH

84/4427-48

Comp. 25 BOPD

COMPLETED

County **Harper** State **Kansas**

Sec. 12 (Blk. Twp.) 31 (Sur. Rge.) 9W Map No.

Operator **Beardmore Drlg.**

Well No. 1 Farm Muir

Elev.	' Location	NE SE SE
-------	------------	-----------------

FIRST REPORT

990 Ft. From S Line SE

330 Ft. From E Line Quarter

1st. Report APR 25 1951

Completion

Remarks

Beardmore Drlg. - Contr.

Spudding Date

Drlg. Data

Location

J. E. TYRA

J. E. LYRA