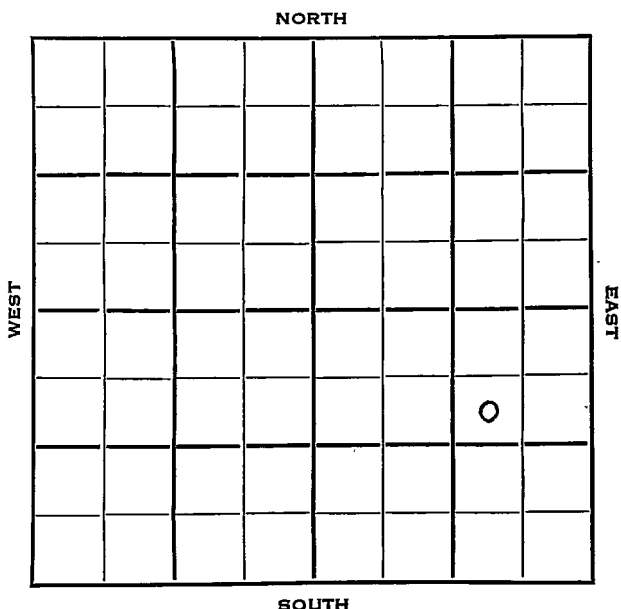


Section 12 Township 31 Range 9WWell No. 2 MuirCompany Beardmore Drlg.

Harper

SEC.	TWP.	R.	NSAS
12	31	9W	✓

WELL NO.

#2 Muir

FARM

COMPANY

Beardmore Drlg.

CONTRACTOR


Beardmore

990 _____ Ft. from N. Line

_____ Ft. from S. Line

990 _____ Ft. from E. Line

_____ Ft. from W. Line

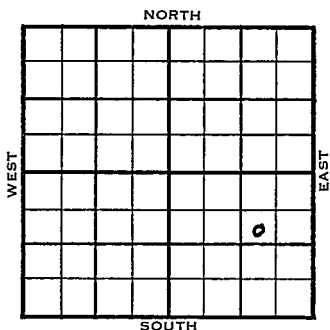

SW NE SE

	ELEVATION	REPORT
1953	1675'	

12/30	Location
1954	
1/6	RUR
1/13	8" @ 183' Drlg 3340'
1/20	Miss 4425' Drlg. 4455'
1/27	D & A
2/10	Spud 1-6-54 D&A TD 4500' 8" @ 183' Miss 4425' DST 4460-70', opn 1 hr., rec. 90' mud, TD 4500' Heeb 3471', Doug 3584', Lans 3675' D&A

ABANDONED

County **Harper** State **Kansas**

Sec. **12** (Blk. **31** (Sur. **9W** Map No.

Operator **Beardmore Drig.**

Well No. **2** Farm **Muir**

Elev.	Location	SW	NE	SE
-------	----------	----	----	----

FIRST REPORT

990 Ft. From N Line SE

990 Ft. From R Line Quarter

1st. Report DEC 30 1953

Completion

Remarks

Beardmore - Contr.

Spudding Date

Drlg. Data -

Location

Kansas


County Harper State

Sec. 12 (Blk. Twp.) 31 (Sur. Rge.) 9W Map No.

Operator Beardmore Drlg.

Well No. 2 Farm Muir

Elev. 1675 Location SW NE SE

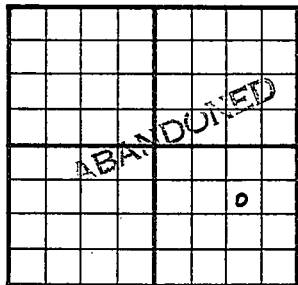

990 Ft. From N Line SE

990 Ft. From E Line Quarter

1st. Report

Completion FEB 10 1954

Remarks

Beardmore Drlg. - Contr.

Spudding Date 1-6-54

Drlg. Data D & A TD 4500

8" @ 183 Miss. 4425 DST 4460-70

open 1 hr. Rec. 90' mud TD 4500

Heeb. 3471 Doug. 3584 Lans. 3675

D & A

J. G. McGEHEE