Harper **KANSAS**

SECTION 12 TOWNSHIP 31 RANGE 9 W

WELL NO. #3 Muir

COMPANY M. B. Armer

NORTH

WEST

EAST

SOUTH

FORM 504-3 SUNRAY

Harper **KANSAS**

SEC.	TWP.	R.
12	31	9W

WELL NO.

#3 Muir FARM

COMPANY

M.B. Armer

CONTRACTOR

Co. Tools

Grabs

_____ Ft. from N. Line

_____ Ft. from S. Line

_____ Ft. from E. Line

_____ Ft. from W. Line

C E½ SE NE

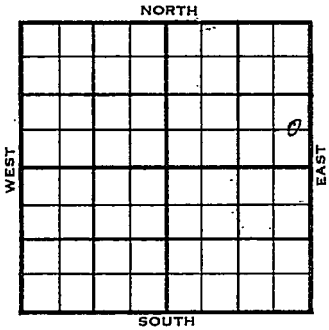

1955	ELEVATION 1669' REPORT
12-21	MIR
1956	
4-18	Comm. 12-20-56 8 5/8" @ 156 w/100 DST 4417-32 op 2 hrs. gas to surface in 19 min. rec. 135' ho&gcm, 90' froggy ~~in~~ oil, 30' clean oil~~in~~, 1355/30" 5½" @ 4420/150 CO to 4430,frac Comp. 214 bopd H. 3476 L. 3664 M. 4416 TD 4432'

COMPLETED

DX-78

FORM 513 REV. SUNRAY

County Harper Elev.

Sec. 12 Twp. 31 Rge. 9W

Company M. B. Armer

Farm Name Mitty No. 3

TOPS	DEPTH	LOG	DATUM
Anh.			
Tp.			
H.			
Tr.			
Dg.			
Bl.			
L.			
K.C.			
B.K.C.			
Ce.			
C.			
M.			
M.			
K.			
Mz.			
Mo.			
V.			
S.			
S.			
A			
R.			
P€.			
G.			
T.D.			

Loc. in Sec. C E½ SE NE

Geol.

Contr. Co. tools

Pool Grabs

FIRST REPORT

DEC. 21 '55

Date Comm.

M I R

Co.

Lse.

No.

Sec.

T.

R.

FORM 513 REV. SUNRAY

County Harper Elev. 1669

Sec. 12 Twp. 31 Rge. 9W

Company M. B. Armer

Farm Name Muir No. 3

TOPS	DEPTH	LOG	DATUM
Anh.			
Tp.			
H.	3476		
Tr.			
Dg.			
Bl.			
L.	3664		1995
K.C.			
B.K.C.			
Ce.			
C.			
M.	4416		2747
M.			
K.			
Mz.			
Mq.			
V.			
S.			
S.			
A			
R.			
P€.			
G.			
T.D.	4432		

Loc. in Sec. C E½ SE NE

Geol.

Contr. Co. tools

Pool Grabs

COMPLETE

Date Comm. 12-20-56 APR 18 1956

8 5/8" @ 156/100 DST 4417-32

open 2 hr. gas to surface in 19 min.

rec. 155' ho & gcm 90' froggy oil

30' clean oil 1355/30" 5½" @ 4420/150

CO to 4430 frac Comp. 214 bopd

Co. Lse. No. Sec. T. R.