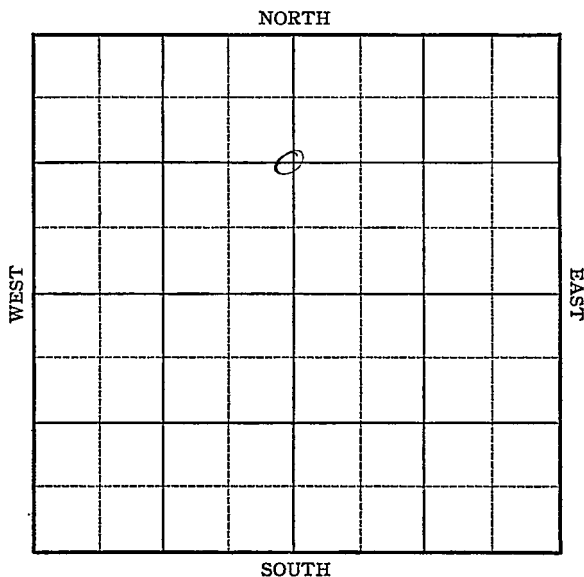


Section 12 Township 31 Range 35 -W

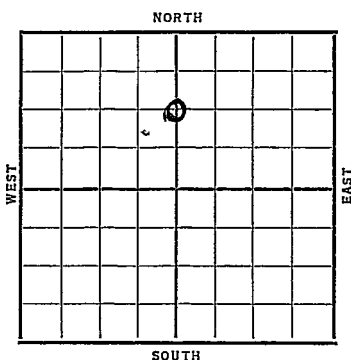
Well No. #1 Bearsley

Company United Prod.



O.W.W.S. KANSAS

Stevens

Sec. 12 Twp. 31 R. 35-7Well No. #1 Beardsley FarmUnited Prod. CompanyHugoton Pool1320 Ft. from N. Line Ft. from S. Line2640 Ft. from E. Line Ft. from W. LineC N/2 Sec.Elev. 3967

Date	REPORT
1937	
9/29	R U R
10/8	"
10/15	10" @ 584'. WOC.
10/22	Drilg. 2100'.
10/29	7" @ 2525'. WOC.
11/5	" " "
11/12	T.D. 2722'. 1½ M gas. 3000 acid
11/17	7" @ 2525'.
	Sand ?
	T.D. 2722'.
	80 qts.
	3000 acid.
	3 M gas.
	COMPLETED
	OVER

1955

1/19

O.W.W.O.

OTD 2722 CO to 2729 5" liner
@ 2513 1" tubing @ 2727 1000 A
2.768 MCFG Acidizing.

2/9

Gas well TD 2729 OTD 2722
CO to 2729 5" @ 2513 1000 A
2,786 MCFG frac 1000 A
2,903,000 CFG 3000 A 3,391,000 CFG
Comp. 7,616,000 CFGPD 353#

COMPLETED

Stevens KANSAS

Map No. _____ Sec. 12 Twp. 31 R. 35WWell No. 1-BeardsleyUnited Prod. Company

Contractor _____

COMPLETED

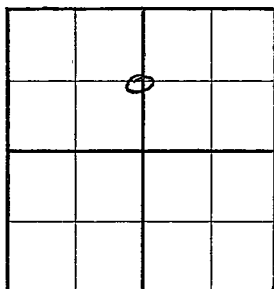
C $N\frac{1}{2}$ 1320 Ft. from N. Line

_____ Ft. from S. Line

2640 Ft. from E. Line

_____ Ft. from W. Line

SECTION PLAT



Location _____

Rig up _____

Drilling and Remarks:

80 gts
3000 acid
3 M. gas

RECORD

Cased 7 in., 2525 ft.Sand ?

Gas _____

Oil _____

Total Depth 2722

PRODUCTION

1st 24 hrs. Nat. _____

1st 24 hrs. after shot _____

Gas _____ Cu. Ft.

Dry Hole _____

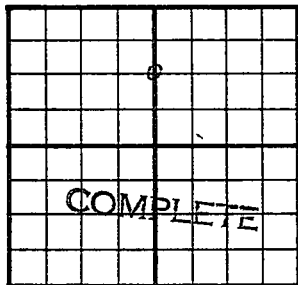
Abandoned _____

Date

NOV 17 1937 19H. D. Hatfield Scout

FABEN GILSTRAP

O.W.W.O.

County Stevens State KansasSec. 12 (Blk. 31) (Sur. 35W) Map No. Operator United ProductionWell No. 1 Farm M. BeardsleyElev. 3967 Location C N $\frac{1}{2}$ Sec.1320 Ft. From N Line Sec.2640 Ft. From E Line Quarter1st. Report Completion FEB 9 1955Remarks O.W.W.O.Spudding Date Drilg. Data Gas well TD 2729OTD 2722 CO to 2729 5" @ 25131000 A 2,786 mcf/g frac 1000 A2,903,000 c/g 3000 A 3,391,000 c/gComp. 7,616,000 c/gpd 353#

FABEN GILSTRA

Stevens KANSAS

Map No. MM Sec. 12 Twp. 31 R. 35WWell No. 1-BeardsleyUnited Prod

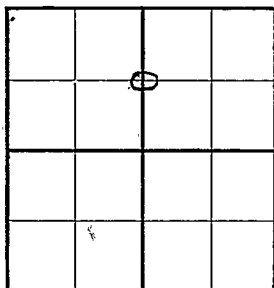
Company

Contractor

FIRST REPORT

C $N\frac{1}{2}$ 1320 Ft. from N. Line Ft. from S. Line2640 Ft. from E. Line Ft. from W. Line

SECTION PLAT

Location Rig up

Drilling and Remarks:

RUR

RECORD

Cased in., ft.Sand Gas Oil Total Depth

PRODUCTION

1st 24 hrs. Nat. 1st 24 hrs. after shot Gas Cu. Ft.Dry Hole Abandoned

Date

SEP 29 1934H. D. Hatfield Scout