

WELL LOG BUREAU—KANSAS GEOLOGICAL SOCIETY
508 East Murdock, Wichita, Kansas


20 - 31 - 13W

Company. JONES-GEBERT OIL CO.
Farm. Hartley No.1

SEC. 20 T. 31 R. 13W
C SE NE

Total Depth. 4548'
Comm. 10-9-62 Comp. 10-28-62
Shot or Treated.
Contractor.
Issued. 2-23-63

County Barber
KANSAS

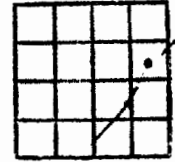

8 5/8" CASING:
290' cem w/250 sx.

Elevation. 1589' KB


Production. DRY

Figures Indicate Bottom of Formations.

surface	290	
shale	360	
shale & shells	1200	
shale	1640	
shale & lime streaks	1815	
lime	2230	
lime & shale	2290	
lime w/shale streaks	2435	
lime & shale	2550	
shale & lime	2887	
shale & lime streaks	3015	
shale & lime	3110	
lime & shale	3414	
shale & lime	3563	
lime & shale	3691	
Douglas sand & Kansas City lime	3742	
lime & shale & sand	3744	
Kansas City-lime	3832	
lime	3875	
lime & shale	3991	
lime & shale	4024	
lime w/chert	4062	
lime	4180	
lime & chert	4225	
lime & shale w/chert	4269	
chert	4270	
Mississippian	4280	
cherty lime	4298	
lime & chert sections	4350	
lime & chert & shale	4409	
lime	4467	
lime & chert	4481	
lime & shale	4512	
Simpson ?	4517	
lime, sand-dolomite	4543	
lime, sand-dolomite ?	4544	RTD
lime, sand-dolomite ?	4548	
Total Depth		
TOPS: LOG		
Heebner	3560	
Douglas	3584	
		Douglas Sand 3683
		Lansing 3728
		Base Kansas City 4085
		Massey Lime 4180
		Mississippian 4214
		Kinderhook 4314
		Misener 4390
		Viola 4400
		Simpson Shale 4492
		Simpson Sand 4511

20-31-13W

SE NE
20-31-13

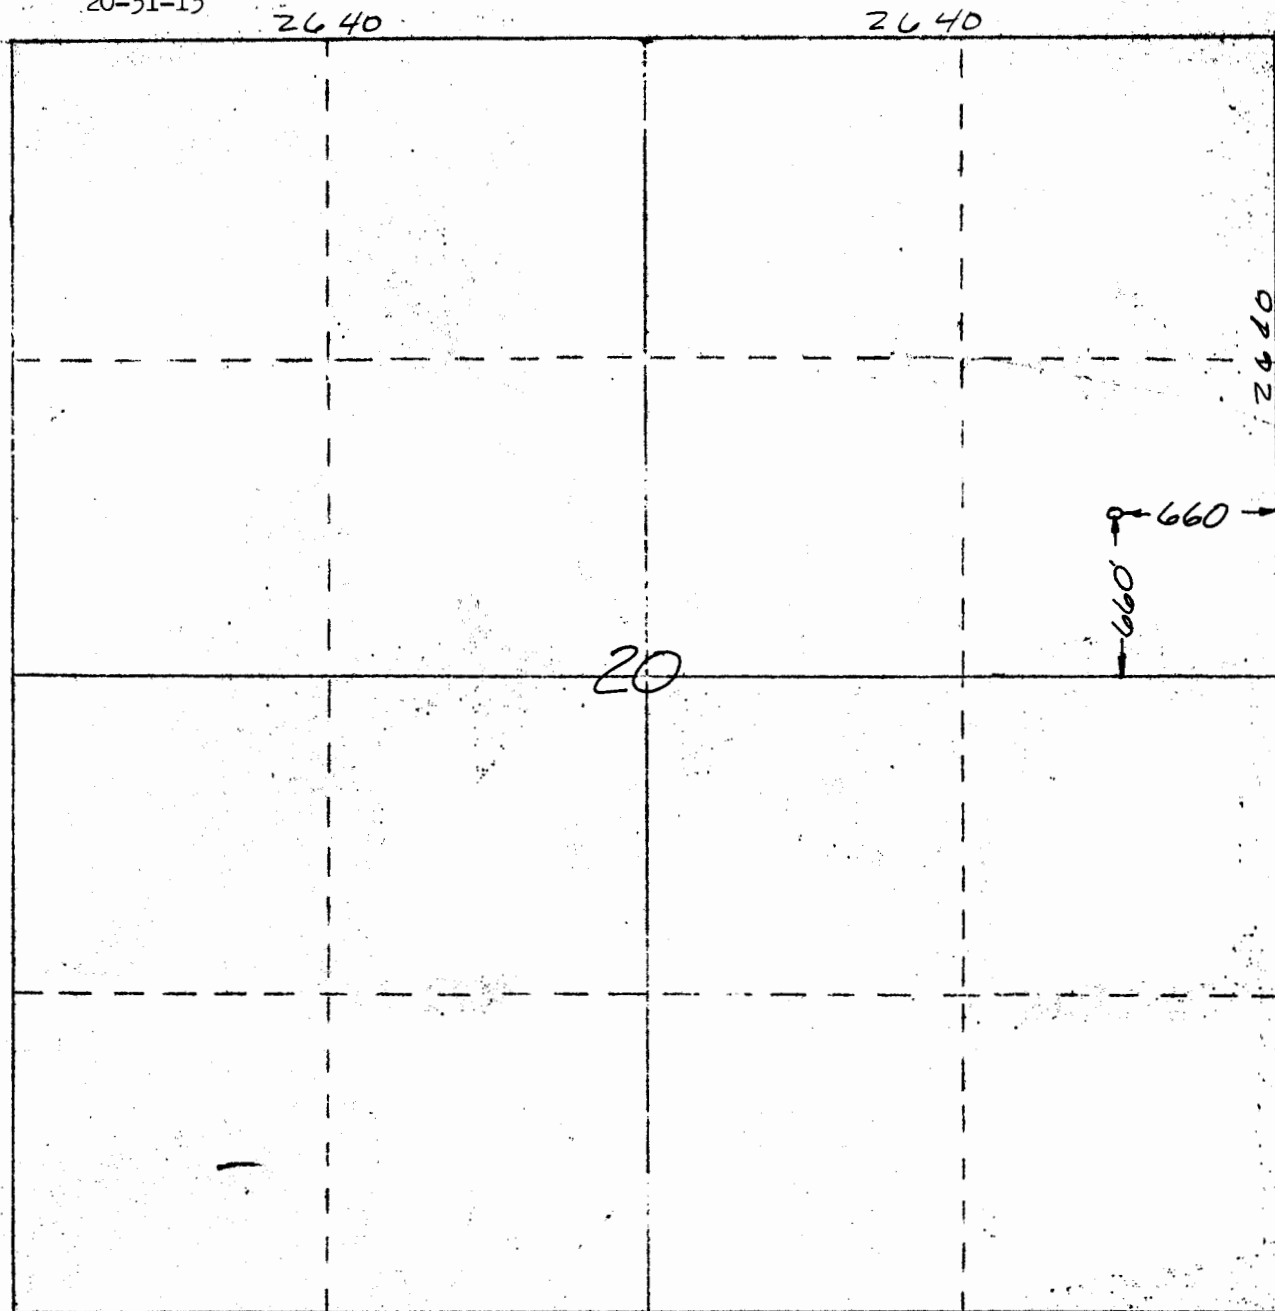

LOCATION center of the SE $\frac{1}{4}$ of the NE $\frac{1}{4}$ of Section 20, Township 31S, Range 13W

STAKED BY

Leroy E. Willis
LEROY E. WILLIS
COUNTY ENGINEER

DATE STAKED October 3, 1962

STAKED FOR Jones - Gebert Oil Inc
1007 Central Bldg.
Wichita, Kansas

RECEIVED _____

ASSIGNED _____

OCT 8 1962

APPROVED _____
JONES - GEBERT OIL, INC.