

8/10
Ind

STATE CORPORATION COMMISSION OF KANSAS
OIL & GAS CONSERVATION DIVISION

WELL COMPLETION OR RECOMPLETION FORM
ACO-1 WELL HISTORY

DESCRIPTION OF WELL AND LEASE

Operator: License # 5205
Name Mid Continent Energy
Address 120 S. Market
Suite 310
City/State/Zip Wichita, KS 67202

Purchaser Central States Gas Company
1700 Lincoln, Suite 4400
Denver, CO 80203

Operator Contact Person Bradley Buehler
Phone 316-265-9501

Contractor: License # 5418
Name Allen Drilling Company

Wellsite Geologist Doug McGinness
Phone 267-6065

Designate Type of Completion
 New Well Re-Entry Workover
 Oil SWD Temp Abd
 Gas Inj Delayed Comp.
 Dry Other (Core, Water Supply, etc.)
If **OWO**: old well info as follows:

Operator
Well Name
Comp. Date Old Total Depth.....

WELL HISTORY

Drilling Method:
 Mud Rotary Air Rotary Cable
6-24-85 7-5-85 7-6-85
Spud Date Date Reached TD Completion Date
4489 4486
Total Depth PBD

Amount of Surface Pipe Set and Cemented at 220 feet
Multiple Stage Cementing Collar Used? Yes No
If yes, show depth set 2283 feet
If alternate 2 completion, cement circulated from.....feet depth to.....w/.....SX cmt


API NO. 15-007-22,056
County Barber
W/2 NE NE/4 Sec. 22 Twp. 22-31-13 Rge. 13
 East West

4620 Ft North from Southeast Corner of Section
990 Ft West from Southeast Corner of Section
(Note: Locate well in section plat below)

Lease Name packard Well # 4
Nurse
Field Name Nurse Ext. Gates North *

Producing Formation Viola
Elevation: Ground 1578 KB 1583

Section Plat

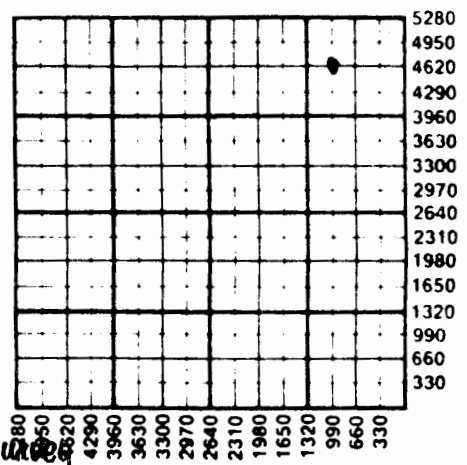

OCT 28 1985

State Geological Survey

WICHITA BRANCH WATER SUPPLY INFORMATION

Disposition of Produced Water: Disposal Repressuring
Docket #

Questions on this portion of the ACO-1 call:
Water Resources Board (913) 296-3717

Source of Water:
Division of Water Resources Permit #
 Groundwater.....Ft North from Southeast Corner (Well)Ft West from Southeast Corner of Sec Twp Rge East West
 Surface Water.....Ft North from Southeast Corner (Stream, pond etc).....Ft West from Southeast Corner Sec Twp Rge East West
 Other (explain)..... (purchased from city, R.W.D. #)

INSTRUCTIONS: This form shall be completed in duplicate and filed with the Kansas Corporation Commission, 200 Colorado Derby Building, Wichita, Kansas 67202, within 90 days after completion or recompletion of any well. Rule 82-3-130 and 82-3-107 apply.
Information on side two of this form will be held confidential for a period of 12 months if requested in writing and submitted with the form. See rule 82-3-107 for confidentiality in excess of 12 months.
One copy of all wireline logs and drillers time log shall be attached with this form. Submit CP-4 form with all plugged wells. Submit CP-111 form with all temporarily abandoned wells.