

KANSAS

FORM 51 5M 4-41 PETROL


Barber

Section 13 Township 31 Range 14-W

Well No. #1 Riepe

Company Pryor & Lockhart et al

^Wildcat

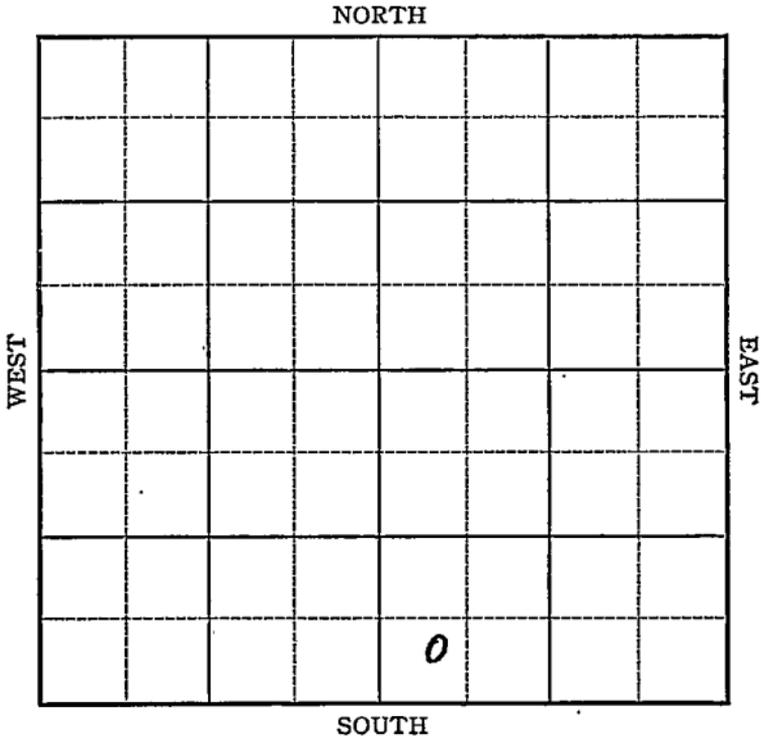

KANSAS

Barber

Sec. 13 Twp. 31 R. 14-W

Well No. #1 Riepe Farm

Pryor & Lockhart et al. Company


(Wildcat)

_____ Ft. from N. Line

440 Ft. from S. Line

_____ Ft. from E. Line

440 Ft. from W. Line

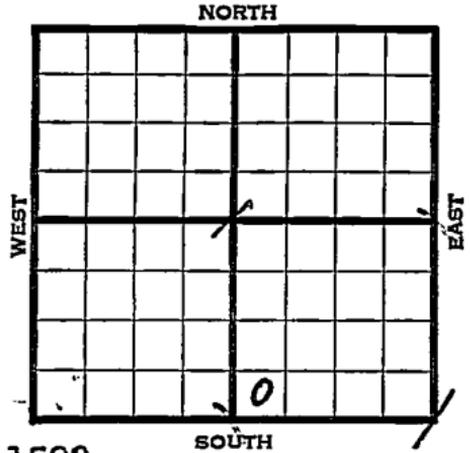

Elev. 1592

1941	REPORT
12/17	Location
12/24	"
12/31	Rotary.
1942	
1/8	"
1/15	20" - 30' 12" - 171'
	Anhy 545' Drlg. 1900'
1/22	Ft. Riley 1955' Topeka 28 20'
	Drlg. 3500'
1/29	Lans. 3737' S.O. 3839-56'
	Drlg. 4149'
2/4	Miss. 4258'
	B. Miss. 4289'
	Viola 4350'
	Arb. 4570'
	T.D. 4586 $\frac{1}{2}$ '
	No shows.
	ABANDONED

Barber

KANSAS

Map No. 93 Sec. 13 Twp. 31 R. 14WWell No. 1 RiepePryor & Lockhart et al. Company

Contractor

FIRST REPORT

SW SE

 Ft. from N. Line440 Ft. from S. Line Ft. from E. Line440 Ft. from W. Line

SECTION PLAT

		X	X
		o	

WILDCAT

Location XXRig up Drilling and Remarks:

RECORD

Cased in., ft.Sand Gas Oil Total Depth

PRODUCTION

1st 24 hrs. Nat. 1st 24 hrs. after shot Gas Cu. Ft.Dry Hole Abandoned

Date

DEC 17 1941

19

S. J. LEWIS

Scout

Map No. 93 Sec. 13 Twp. 31 R. 14W

Well No. 1 Riepe

Pryor & Lockhart Company

ABANDONED Contractor

SW SE


SECTION PLAT

_____ Ft. from N. Line

440 Ft. from S. Line

_____ Ft. from E. Line

440 Ft. from W. Line

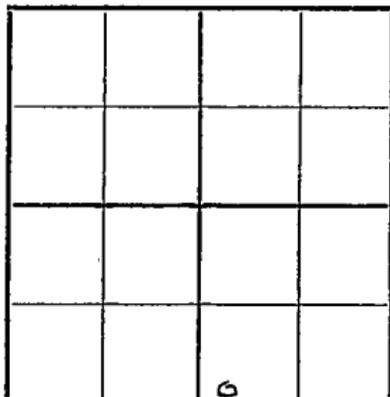

WILDCAT

RECORD

Location _____

Cased _____ in., _____ ft.

Rig up _____

Sand _____

Drilling and Remarks:

Gas _____

Miss 4258

Oil _____

B. Miss 4289

Total Depth 4586 1/2




PRODUCTION

1st 24 hrs. Nat. _____

1st 24 hrs. after shot _____

Gas _____ Cu. Ft.

Dry Hole _____

Abandoned _____

Date

FEB 4 1942 19

S. J. LEWIS Scout