


Section 13 Township 31 Range 38W

Well No. #1 Newman

Company Hugoton Prod.

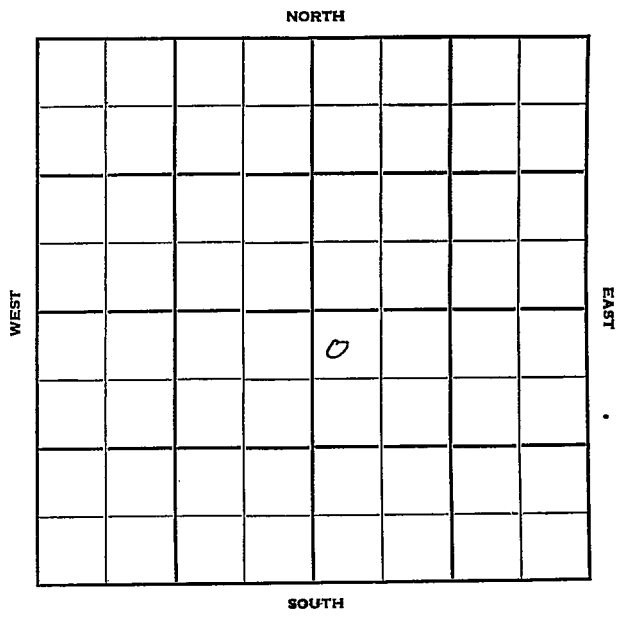

Stevens

KANSAS ✓

Sec. 13 Twp. 31 R. 38W

Well No. #1 Newman Farm

Hugoton Prod. Company

Contractor


200' Ft. from N. Line

Ft. from S. Line

Ft. from E. Line

240' Ft. from W. Line

NW NW SE

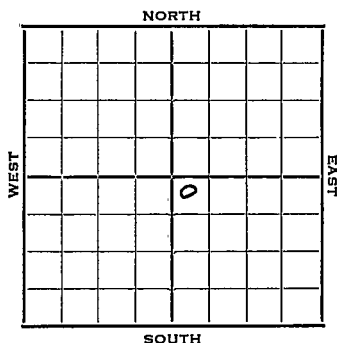

1952 Elev. 3130 R E P O R T

4/30 Location
5/7 "
5/14 Drlg. 470'
5/21 10" @ 520' w/375 sks.
RTD 2457' 7" @ 2440 WOC
5/28 TD 2684' 250' of 5" liner
6/11 NR
6/18 NR
6/25 "
7/2 Hol 2404' Her 2443' Krider 2460'
Winfield 2530' Up Ft. 2593'
Low Ft. 2653'
20,000 A
7/9 NR
7/16 Spud 5-13-52
Gas Well TD 2684
10" @ 520 7" @ 2440 TD 2684
Hol. 2404 Her. 2443 Kri 2460
Win 2530 Ft. Riley 2593
20,000 A Comp. 42,968,000 gas 385#

COMPLETED

Sec.	13	(Blk. Twp.)	31	(Sur. Rge.)	S8W	Map No.
------	----	-------------	----	-------------	-----	---------

Operator Hugoton Prod.

Well No. **1** Farm **Newman**

Elev.	Location	NW	NW	SE
-------	----------	----	----	----

FIRST REPORT

200 Ft. From N Line SM

240	Ft. From	Line	Quarter
-----	----------	------	---------

1st. Report APR 30 1952

Completion

Remarks

Spudding Date

Drlq. Data

Location


J. G. McGEHEE

County Stevens State Kansas
 Sec. 13 (Blk.) 31 (Sur.) 38W Map No.

Operator Hugoton Prod.

Well No. 1 Farm Newman

Elev. 3130 Location NW NW SE

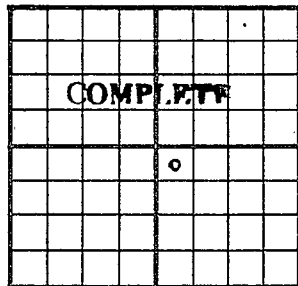

200 Ft. From N Line SE

240 Ft. From W Line Quarter

Ist. Report

Completion JUL 16 1952

Remarks

Spudding Date 5-13-52

Drlg. Data Gas well TD 2684

10" @ 520 7" @ 2440 TD 2684

Hol. 2404 Her. 2443 Kri. 2460

Win. 2530 Ft. Riley 2593 20000 A

Comp. 42,968,000 gas 385#

J. G. McGEHEE