FORM 51 10M 2-49 PETROL

KANSAS


Stevens

Section 13 Township 31 Range 37W

Well No. 1 Fox

Company Hugoton Prod

Hugoton

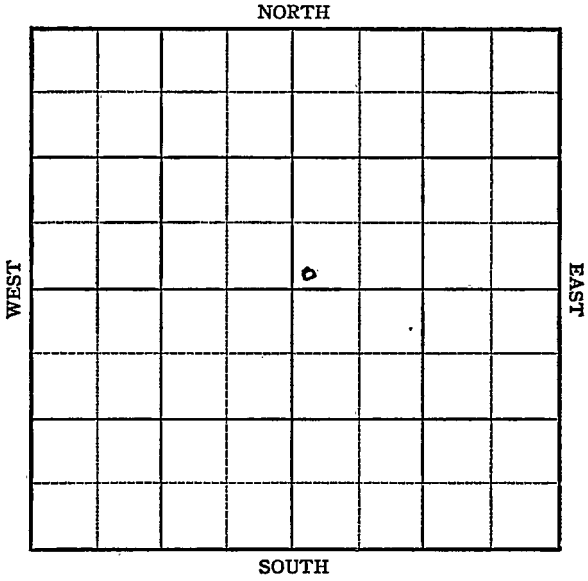

FORM 252-A
5M 10-48 PETROL

KANSAS Stevens

Sec. 13 Twp. 31 R. 37W

Well No. #1 Fox Farm

Hugoton Prod. Company

Hugoton Pool


____ Ft. from N. Line

100' Ft. from S. Line

____ Ft. from E. Line

100' Ft. from W. Line

SW NE

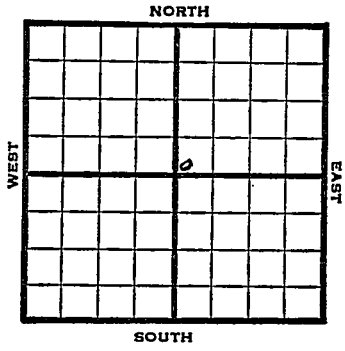

1949	Elev 3087' REPORT
3/9	Location
3/16	RUR
3/23	10"@ 562 Drlg 2150'
3/30	TD 2540' 7" @ 2532'
4/6	TD 2785' 266' of 5" Perf liner @ 2785
4/12	"
4/20	"
4/27	"
5/4	"
5/10	"
5/18	"
5/25	"
6/1	"
6/7	"
6/15	"
6/21	"
6/29	TD 2785' 7"@ 2532' 266' of 5" Perf Liner @ 2785' 3,075,000 Gas 430# R PR Comp COMPLETED

Form 26 200 Bks. 9-48 Petrol

Kansas

Hugoton Pool

Map No. _____ Sec. 13 Twp. 31 R. 37W


Well No. 1 Fox

Hugoton Prod. Company

FIRST REPORT Contractor

SW NE

SECTION PLAT

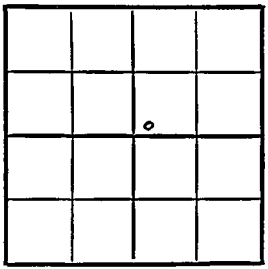

_____ Ft. from N. Line

100 Ft. from S. Line

_____ Ft. from E. Line

100 Ft. from W. Line

Stevens County

Location x

Rig up

Drilling and Remarks:

RECORD

Cased _____ in., _____ ft.

Sand

Gas

Oil

Total Depth

PRODUCTION

1st 24 hrs. Nat.

1st 24 hrs. after shot

Gas _____ Cu. Ft.

Dry Hole

Abandoned

Date

MAR 9 1949 19 S. J. LEWIS Scout

Form 26 200 Bks. 6-49 Petrol

Kansas

Hugoton Pool

Map No. 9 Sec. 13 Twp. 31 R. 37W

Well No. 1 Fox


Hugoton Prod. Company

COMPLETE Contractor

SW NE

E1,3087

SECTION PLAT

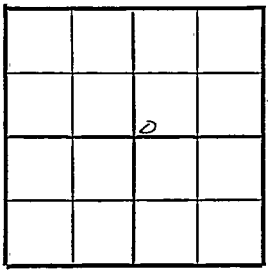

____ Ft. from N. Line

100 Ft. from S. Line

____ Ft. from E. Line

100 Ft. from W. Line

Stevens County

Location

Rig up

Drilling and Remarks:

7" @ 2532

266' of 5" liner

@ 2785'

3,075,000 Gas

433 * R/L

RECORD

Cased ____ in., ____ ft.

Sand

Gas

Oil

Total Depth 2785'

PRODUCTION

1st 24 hrs. Nat.

1st 24 hrs. after shot.

Gas ____ Cu. Ft.

Dry Hole

Abandoned

Date

JUN 29 1949 19

S. J. LEWIS Scout