


Section 13 Township 31 Range 34-W
Well No. #1 Ives
Company Cities Service

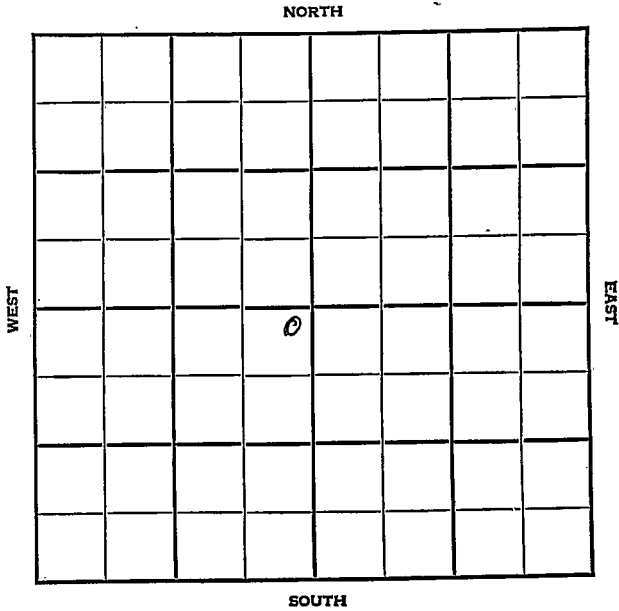

KANSAS

Seward

Sec. 13 Twp. 31 R. 34W

Well No. #1 Ives Farm

Cities Service

Company

Hugoton Pool


100' Ft. from N. Line

 Ft. from S. Line

100' Ft. from E. Line

 Ft. from W. Line

NE SW

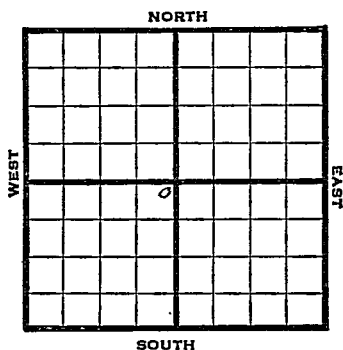

1948

Elev. 2928' REPORT

7/21	8" @ 640'	
7/28	TD 2790'	
	5" @ 2789'	
8/4	"	
8/11	"	
8/18	100 shots 2728-54	7000 acid
8/25	130 shots 2680-2706'	
	170 shots 2628-2662'	
	70 shots 2676-90	2000 acid
9/1	9000 acid	
9/8	"	
9/14	"	
9/22	5" @ 2789'	
	TD 2790'	
	Perf.	
	Acid 36,000	
	Gas 15,100,000	
	R. Pr. 391#	

COMPLETED

Hugoton Pool

Map No. _____ Sec. 13 Twp. 31 R. 34W

Well No. 1 Ives

Cities Service Company

FIRST REPORT Contractor

NE SW

SECTION PLAT

100 Ft. from N. Line

 Ft. from S. Line

100 Ft. from E. Line

 Ft. from W. Line

	o		

Seward County

Location _____

Rig up _____

Drilling and Remarks:

8" @ 640

RECORD

Cased _____ in., _____ ft.

Sand _____

Gas _____

Oil _____

Total Depth _____

PRODUCTION

1st 24 hrs. Nat. _____

1st 24 hrs. after shot _____

Gas _____ Cu. Ft.

Dry Hole _____

Abandoned _____

Date

JUL 21 1948 19 S. J. LEWIS Scout

Seward County Kansas State

Map No. _____ Sec. 13 Twp. 31 R. 34W

Well No. 1 Ives

Cities Service Company

COMPLETE

Contractor

NE SW

E1.28.28

SECTION PLAT

100 Ft. from N. Line

_____ Ft. from S. Line

100 Ft. from E. Line

_____ Ft. from W. Line

Hugoton Pool

Remarks:

5" Q2789

702790

Perf.

36000 acid

15,100,000 gas

291 # R¹²

Date
SEP 22 1948

Scout
S. J. LEWIS