

DX 78-1


Harper

KANSAS

Section 13 Township 31 Range 9W

Well No. #3 Grabs

Company Drillers Prod.

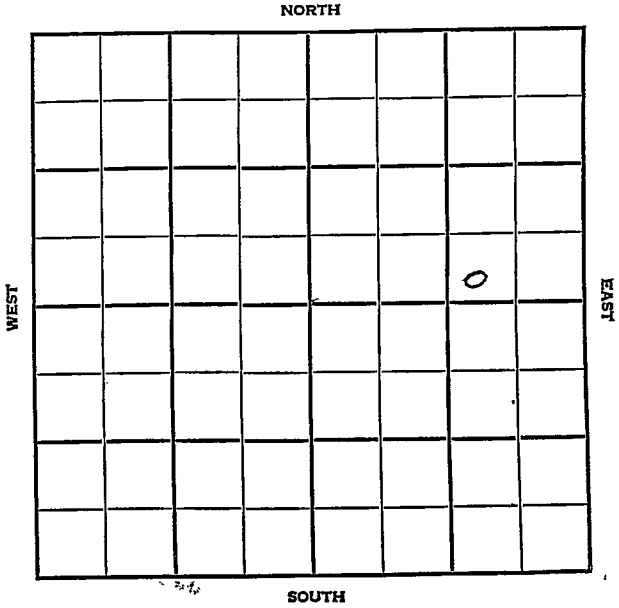

SEC. 13	TWP. 31	R. 9W
------------	------------	----------

WELL NO. #3 Grabs FARM

COMPANY Drillers Prod.

CONTRACTOR Beardmore


_____ Ft. from N. Line

_____ Ft. from S. Line

_____ Ft. from E. Line

_____ Ft. from W. Line

SW SE NE

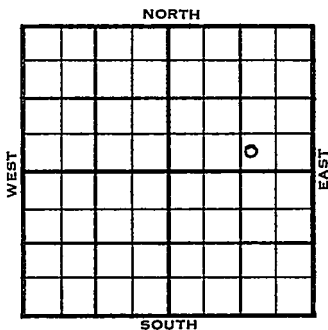

1955	ELEVATION 1640	REPORT
------	-------------------	--------

6/15

Comm. 5-8-55
 8" @254/175 DST 4406-18, gas in 2"
 768 mcfg 1 hr. Rec. 35' oil 90' ho &
 gcm 1515/20" 5 1/2 @ 4423/100 CO to 4433
 FU 850' fluid 13 hr. 50% oil 110 M*A
 S/1 bfph set 14 hr. S/15 bo frac F/24
 bfph 26% wtr. 4 hr. Comp F/348 bopd
 10% wtr.

Tops:	Datum
M. 4403	2763
TD. 4433	

FIRST REPORT



COMPLETED

County Harper ✓ Elev. 1640
 Sec. 13 Twp. 31 Rge. 9W
 Company Drillers Prod.
 FarmName Grabs No. 3

TOPS	DEPTH	LOG	DATUM	Loc. in Sec.
Anh.				SWSE NE
Tr.				
H.				
Tr.				
Dg.				
Bl.				
L.				Geol.
K.C.				Contr.
B.K.C.				
Ce.				Beardmore
C.				Pool
M.	<u>4403</u>		<u>2763</u>	Grabs
M.				
K.				
Mz.				
Mo.				
V.				
S.				
S.				
A.				
R.				
Pe.				
G.				
T.D.	<u>4433</u>			

Date Comm. 5-8-55 JUN 15 1955

8" @ 254/175 DST 4406-18 gas in 2"
 768 mcfg 1 hr. Rec. 35' oil 90' ho
 & gcm 1515/20" 5½" @ 4423/100
 CO to 4433 FU 850' fluid 13 hr. 50% oil
 110 M-A S/ 1 bfph set 14 hr. S/ 15 bo
 frac F/ 24 bfph 26% wtr. 4 hr.
 Comp. F/ 348 bopd 10% wtr.