

KANSAS

Harper

Section 13 Township 31S Range 9W

Well No. #1 Grabs

Company Drillers Gas et al

NORTH

							0

SOUTH

WEST

EAST

Harper

KANSAS

Sec. 13 Twp. 31 R. 9W ✓

Well No. #1 Grabs Farm

Drillers Gas et al Company

Wildcat (Beardmore Drlg., Cont.) ^{NORTH}


330' Ft. from N. Line

 Ft. from S. Line

330' Ft. from E. Line

 Ft. from W. Line

NE/c

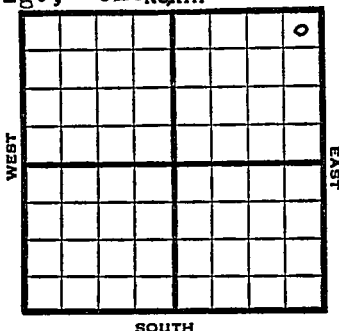

1949 Elev 1638' REPORT

9/14 RUR
9/21 10" @ 262'
Drlg. 2079'
9/28 Drlg 4040'
10/5 Lansing 3634'
Miss 4398
TD 4403
7"@ 4400'
10/12 TD 4449'
Swb 24 bbls oil 13½ hrs.
10/19 PB 4414'
Swb 49½ bbls oil 8 hrs.
10/26 "
11/1 "
11/9 "
11/23 TD 4449'
Miss 4398'
7"@ 4400'
Pump 33 Oil 414% W Pot
29° Gr.
Comp

COMPLETED

Map No. _____ Sec. 13 Twp. 31 R. 9W

Well No. 1 Grabs

Drillers Gas etal. _____ Company

Beardmore Drls. _____ Contractor

NE/C


SECTION PLAT

330 Ft. from N. Line

_____ Ft. from S. Line

330 Ft. from E. Line

_____ Ft. from W. Line

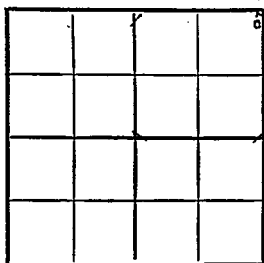

Harper County

Location _____

Rig up _____

Drilling and Remarks:

R U R

RECORD

Cased _____ in., _____ ft.

Sand _____

Gas _____

Oil _____

Total Depth _____

PRODUCTION

1st 24 hrs. Nat. _____

1st 24 hrs. after shot _____

Gas _____ Cu. Ft.

Dry Hole _____

Abandoned _____

Date

SEP 14 1949

19

S. J. LEWIS

Scout

Map No. _____ Sec. 13 Twp. 31 R. 9WWell No. 1 Grabs _____

Drillers Gas et al. _____ Company

COMPLETE

Contractor _____

NE/C

E 1168
SECTION PLAT330 Ft. from N. Line

_____ Ft. from S. Line

330 Ft. from E. Line

_____ Ft. from W. Line

Harper County

			8

Location _____

Rig up _____

Drilling and Remarks:

*Min 4378**7" C4400**Pump 330 oil 7/14/9**P. 1**290 lbs.*

RECORD

Cased _____ in., _____ ft.

Sand _____

Gas _____

Oil _____

Total Depth 4449

PRODUCTION

1st 24 hrs. Nat. _____

1st 24 hrs. after shot _____

Gas _____ Cu. Ft.

Dry Hole _____

Abandoned _____

Date

NOV 23 1949

19

S. J. LEWIS

Scout