


Section 13 Township 31 Range 9W

Well No. #4 Grabs "6"


Company Magnolia Pet.

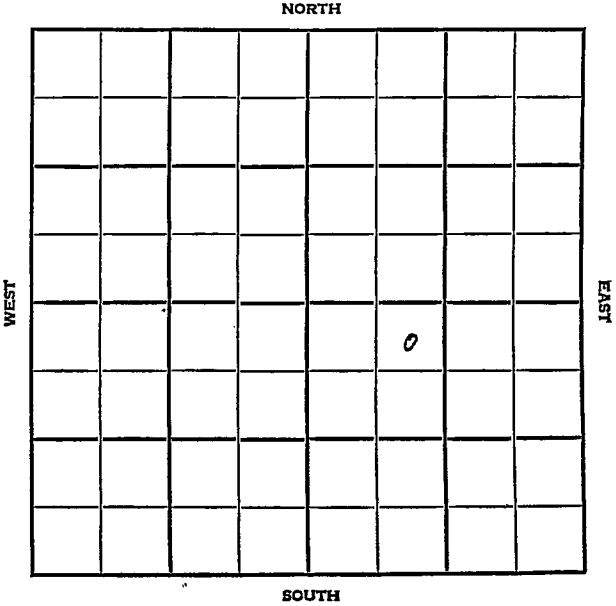

Harper KANSAS

SEC. 13	TWP. 31	R. 9W
WELL NO. 4 Grabs "B"		
COMPANY Magnolia Petr.		FARM
CONTRACTOR		

330 _____ Ft. from N. Line
 _____ Ft. from S. Line
 _____ Ft. from E. Line
 990 _____ Ft. from W. Line

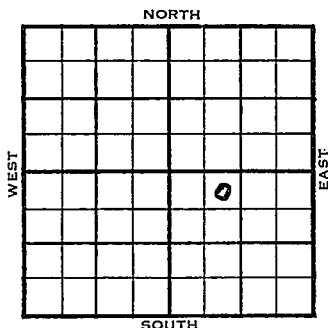

NE NW SE

1955	ELEVATION 1629'	REPORT
------	--------------------	--------

3/9 Location

4/13 Spud 3-11-55 Oil well TD 4490
 9-5/8" @ 230 Miss 4374 TD 4490
 5" @ 4481 CO to 4350 PB 4436
 66/4416-27 S/3 1/2 BO 1/2 BWPB 10 hr.
 Visco frac F/97 BO 4 BSW 10 hr.
 F/114 BO 12 hr. 1.6% wtr.
 F/132 BO 2 BSW 24 hrs.
 Comp. F/489 BOPD 2% wtr.

COMPLETED


Sec. **13** (Blk. **31**) (Sur. **9W**) Map No.

Operator **Magnolia Petroleum**

Well No. 4 Farm Grabs "B"

Elev.	Location	NE	NW	SE
-------	----------	----	----	----

FIRST REPORT

330 Ft. From **N** Line **SE**

990 Ft. From ~~W~~ Line Quarter

1st. Report MAR 9 1955

Completion

Remarks

Spudding Date

Drlg. Data

Location

FABEN GILSTRAP

County Harper State KansasSec. 13 (Blk.
Twp.) 31 (Sur.
Rge.) 9W Map No. _____Operator Magnolia Pet.Well No. 4 Farm Grabs "B"Elev. 1629 Location NE NW SE

330 Ft. From N Line SE990 Ft. From W Line Quarter

1st. Report _____

Completion APR 13 1955

Remarks _____

Spudding Date 3-11-55Drlg. Data Oil well TD 44909 5/8" @ 230 Miss. 4374 TD 44905" @ 4481 CO to 4350 PB 443666/ 4416-27 S/ 3 1/2 bo 1/2 bwph 10 hr.visco frac F/ 97 bo 4 bsw 10 hr.F/ 144 bo 12 hr. 1.6% wtr.F/ 132 bo 2 bsw 24 hr.Comp. F/ 489 bopd 2% wtr.

FABEN GILSTRAP