

DX 78-1

Harper

KANSAS

Section 13 Township 31 Range 9 W

Well No. # 2 Fred Grabs "B"

Company Magnolia Petroleum

NORTH

WEST

EAST

|  |  |  |  |   |  |  |  |
|--|--|--|--|---|--|--|--|
|  |  |  |  |   |  |  |  |
|  |  |  |  |   |  |  |  |
|  |  |  |  |   |  |  |  |
|  |  |  |  |   |  |  |  |
|  |  |  |  |   |  |  |  |
|  |  |  |  | 0 |  |  |  |
|  |  |  |  |   |  |  |  |
|  |  |  |  |   |  |  |  |

SOUTH

|      |      |    |
|------|------|----|
| SEC. | TWP. | R. |
| 13   | 31   | 9W |

WELL NO.

#2 Fred Grabs "B"

FARM

COMPANY

Magnolia Pet.

CONTRACTOR

Noble Drlg.

W. Grabs Pool

990


Ft. from N. Line

Ft. from S. Line

Ft. from E. Line

330

Ft. from W. Line

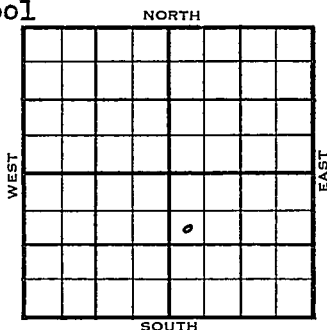

SW NW SE

|      | ELEVATION | REPORT |
|------|-----------|--------|
| 1955 | 1610'     |        |

1/5

Spud 12-29-54

8" @ 219'

Drlg. 3265'

2/2

Spud 12-29-54 Oil well TD 4490

8" @ 219 Miss 4362 TD 4490


5" @ 4489 CO to 4436 36/4398-4404

S/1 BOPH 10% wtr. 2 hr. frac.

Comp. 219 BOPD 2% wtr.

**COMPLETED**

FABEN GILSTRAP

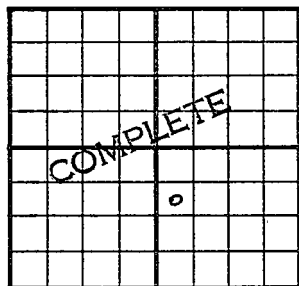County Harper State KansasSec. 13 (Blk.  
Twp.) 31 (Sur.  
Rge.) 9W Map No.Operator Magnolia PetroleumWell No. 2 Farm Fred Grabs "B"Elev. 1610 Location SW NW SE990 Ft. From N Line SE330 Ft. From W Line Quarter

1st. Report

Completion FEB 2 1955Remarks W. Grabs PoolNoble Drlg. - Contr.Spudding Date 12-29-54Drlg. Data Oil well TD 44908" @ 219 Miss. 4362 TD 44905" @ 4489 CO to 4436 36/ 4398-4404S/ 1 boph 10% wtr. 2 hr. fracComp. 219 bopd 2% wtr.

FABEN GILSTRAP