

KANSAS

Company Harry Bass

WEST

EAST

SOUTH

0

Harper

SEC.	TWP.	R.
13	31	KANSAS 9W

WELL NO.

#2 Ryan

FARM

COMPANY

Harry Bass

CONTRACTOR

Purcell & Mull

W. Grabs Pool

Ft. from N. Line


330

Ft. from S. Line

990

Ft. from E. Line

Ft. from W. Line

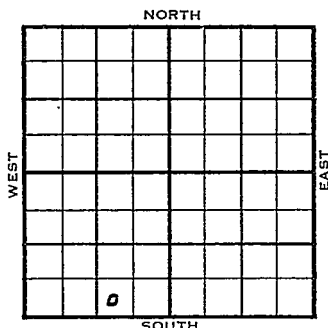

SW SE SW

1954	ELEVATION	REPORT
	1627'	

10/6 Location

11/10 Spud 10-5-54

Oil Well

TD 4467'

8-5/8" @ 190

Miss 4376'

DST 4378'-4400' opn 1 hr, 1,450,000 cfg. 0#

DST 4409'-17' opn 1 hr, rec 95' hoom, 50' free oil, 5' filtrate 0#

DST 4417'-40' opn 2 hr, gas in 3 min, F/ oil in 40 min, rec 90' free oil, 5 gw. 1630#

TD 4467'

5" @ 4455'

Lans 3634'

Miss 4376'

CO to 4447' 128/ 4420-36

F/ 132 bo 8 hr.

Comp 130 bopd. 6% Wtr.

COMPLETED

County **Harper** State **Kansas**

Sec. **13** (Blk. **31** (Sur. **9th** Map No.

Operator **Harry Bass**

Well No. **2** Farm **Ryan**

Elev.	Location	SW	SE	SW
-------	----------	----	----	----

FIRST REPORT

330 Ft. From S Line SW

990 Ft. From E Line Quarter

1st. Report OCT 6 1954

Completion

Remarks

Purcell & Mull - Contr.

Spudding Date:

Drig. Data W. Grabs Pool

Location

FABEN GILSTRAP

