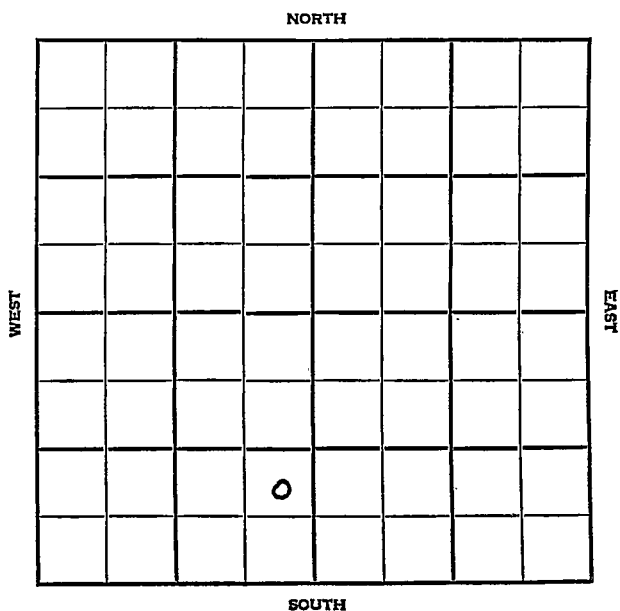


Section 13 Township 31 Range 9WWell No. 4 RyanCompany Harry Bass

Harper KANSAS

SEC.	TWP.	R.
13	31	9W

WELL NO.

4 Ryan

FARM

COMPANY

Harry Bass

CONTRACTOR

Purcell & Mull

W. Grabs Pool


_____ Ft. from N. Line

990 _____ Ft. from S. Line

330 _____ Ft. from E. Line

_____ Ft. from W. Line

NE SE SW

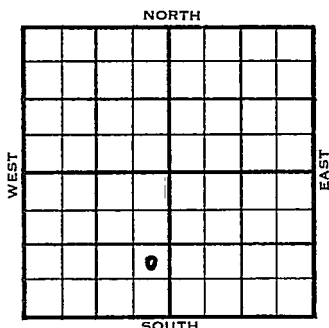

	ELEVATION	REPORT
1954	1598'	

11/3 Drlg. 3605'

12/1 Spud 10-26-54 Oil well TD 4430
 8-5/8" @ 181 Miss 4343
 DST 4374-90 gas in 3 min,
 100,000 CFG 2 hr. 760' clean oil
 1680#
 DST 4390-4410 open 2 hr gas in 3½ min
 F/oil 1 hr. 1610#
 DST 4410-30 open 2 hr rec 135' OCM
 160# TD 4430 5" @ 4430
 112/4392-4408 500 M-A F/8 BOPH
 Comp. F/108 BOPD 3% wtr.

COMPLETED

County Harper State KANSASSec. 13 (Blk. Twp.) 31 (Sur. Rge.) 9W Map No.Operator Harry BassWell No. 4 Farm RyanElev. Location NE SE SW

FIRST REPORT

990 Ft. From S Line SW330 Ft. From E Line Quarter

1st. Report NOV 3 1954

Completion

Remarks

Purcell & Mull - Contr.

Spudding Date

Drig. Data W. Grabs Pooldrig. 3605

FABEN GILSTRAP

