


Harper

DX 78-1

KANSAS

Section 13 Township 31S Range 9W
 Well No. #8 Ryan
 Company Harry Bass

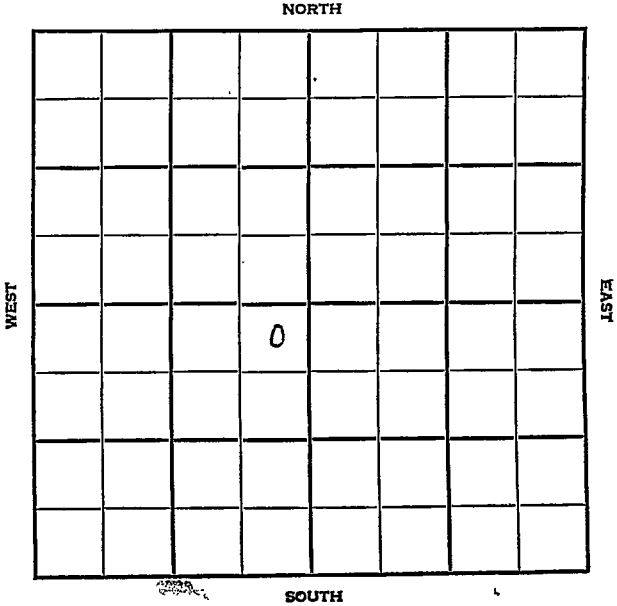

Harper

KANSAS

SEC.	TWP.	R.
13	31S	9W

WELL NO.

#8 Ryan

FARM

COMPANY

Harry Bass

CONTRACTOR

Purcell-Mull Tools.

Grabs.

330


Ft. from N. Line

Ft. from S. Line

330

Ft. from E. Line

Ft. from W. Line

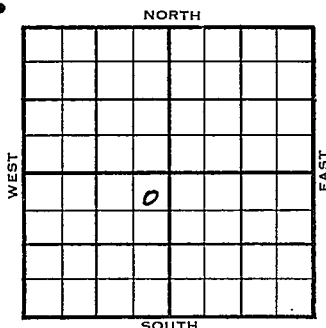

NE NE SW

1954

ELEVATION

1607'

REPORT

12/8

Spud 12-4-54

8" @ 192' w/150 sks.

Drllg. 1672'

1955

1/26

Spud 12-4-54 Oil well TD 4435

8" @ 192 Miss 4356

DST 4390-4415, open 2 hr, gas in 6½ min. F/33 BO 2 hr. 1600# TD 4435

5" @ 4433' CO to 4420

56/4400-08 500 A F/10 BOPH

Comp. F/233 BOPD 3% wtr.


COMPLETED

County Harper State Kansas
 Sec. 13 (Blk. Twp.) 31S (Sur. Rge.) 9W Map No.

Operator Harry Bass

Well No. 8 Farm Ryan

Elev. Location NE NE SW

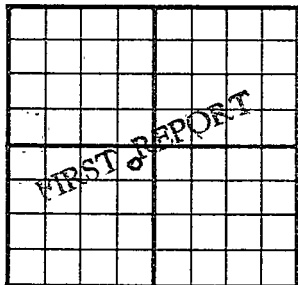

330 Ft. From N Line

330 Ft. From E Line SW Quarter

Ist. Report DEC 8 1954

Completion


Remarks Purcell-Mull tools

Spudding Date 12-4-54

Drig. Data Grabs

8" @ 192 w/150, Drig 1672

FABEN GILSTRAP

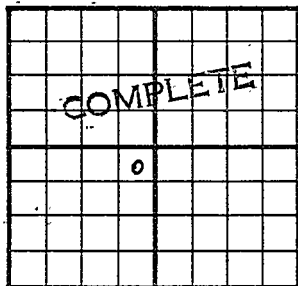County Harper State KansasSec. 13 (Blk.
Twp.) 31 (Sur.
Rge.) 9W Map No.Operator Harry BassWell No. 8 Farm RyanElev. 1607 Location NE NE SW330 Ft. From N Line SW330 Ft. From E Line Quarter

1st. Report

Completion JAN 2 6 1955Remarks Grabs PoolPurcell-Mull - Contr.Spudding Date 12-4-54Drlg. Data Oil well TD 44358" @ 192 Miss. 4356 DST 4390-4415open 2 hr. gas in 6 $\frac{1}{2}$ min. F/ 33 bo 2 hr.1600# TD 4435 5" @ 4433 CO to 442056/ 4400-08 500 A F/ 10 bophComp. F/ 233 bopd 3% wtr.

FABEN GILSTRAP