


Section 14 Township 31 Range 13 W
Well No. # 1 Mathews
Company Wm. Graham Oil & LeBosquet

NORTH

WEST

EAST

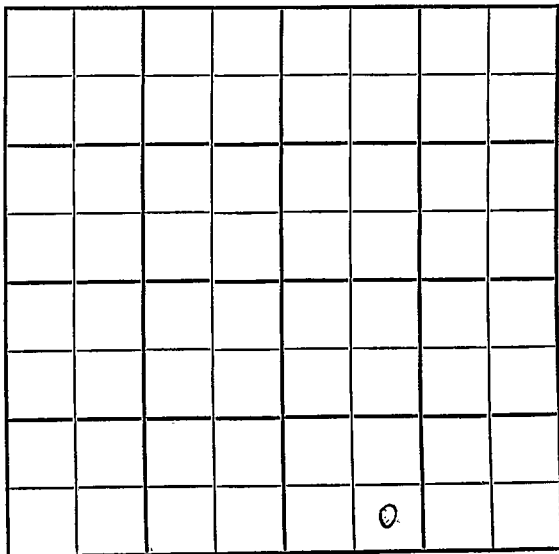

SOUTH

KANSAS

WELL NO.

#1 Mathews.

FARM

COMPANY

Wm. Graham Oil & LeBosquet

CONTRACTOR

Co. Tools.

Nurse Pool

_Ft. from N. Line


330

_Ft. from S. Line

Ft. from E. Line

990

Ft. from W. Line

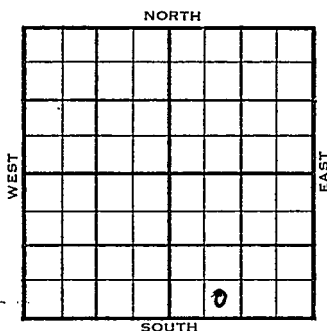

SE SW SE

Franco-Central F/O

1954

ELEVATION

1610'

REPORT

10/6

Spud 9-23-54

8" @ 200"

Elgin Sd. 3385'

Drlg. 3460'

k9.k3

Spud 9-23-54 D & A TD 3604'

8" @ 200 Elgin sd 3385'

Doug. sd 3594'

DST 3574-3604 open 1 hr rec 120' muddy

SW 450' SW 1320' TD 360 1/4'

D & A

ABANDONED

FABEN CH CH 2-1-1


OCT 7

1952

Scout Cards	
Land Spr. Map	
Land Wall M. p	
Tracings	
Fixing Map	
Pierce Map	
Misc.	

Orig. Data

County Barber State Kansas
 Sec. 14 (Blk.
Twp.) 31 (Sur.
Rge.) 13W Map No.
 Operator Wm. Graham & LeBosquet
 Well No. 1 Farm Mathews
 Elev. 1610 Location SE SW SE

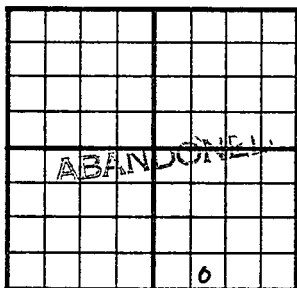

330 Ft. From S Line SE
990 Ft. From W Line Quarter
 1st. Report
 Completion OCT 13 1954
 Remarks Nurse Pool
Bo. tools
 Spudding Date 9-23-54

Drig. Data D & A TD 3604
8" @ 200 Elgin sd. 3385 Doug. sd. 3594
DST 3574-3604 open 1 hr. Rec. 120'
muddy sw 450' sw 1320# TD 3604
D & A

FABEN GILSTADT

Picout Cards	4000
Land Search Map	
Land Use Map	23
Tracings	
France Map	
France Map	
Misc.	

OCT 19 1954

Orig. Date