

Meade

KANSAS


SECTION 14 TOWNSHIP 31 RANGE 30W

WELL NO. #1 J.H. Borth

COMPANY Thomas & Brewer & Alamo Corp.

NORTH

C NE NE

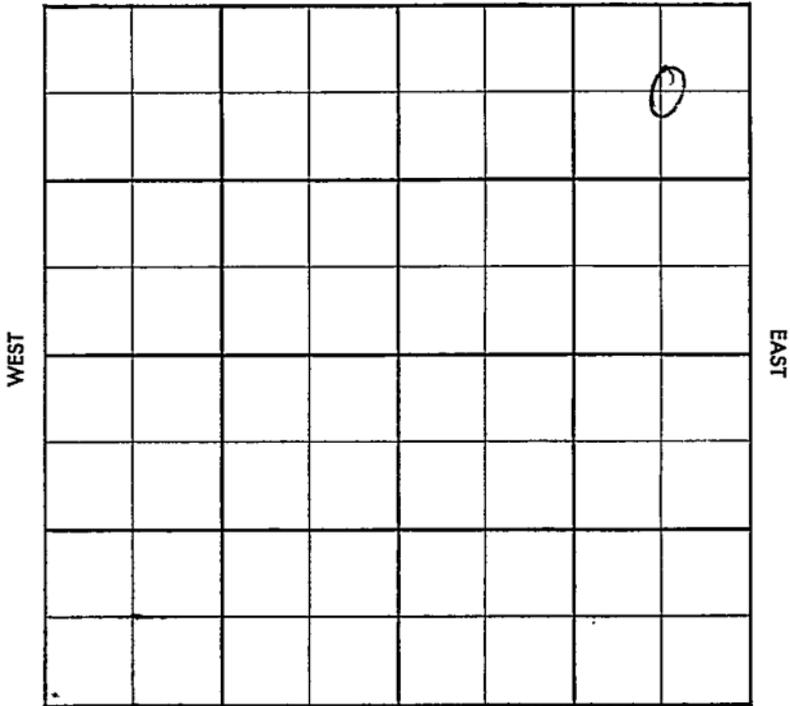

SOUTH

Meade

KANSAS

SEC. 14	TWP. 31 S	R. 30 W
------------	--------------	------------

WELL NO. # 1 J. H. Borth FARM

COMPANY Thomas & Brewer & Alamo Corp.

CONTRACTOR Rine Drlg.

Wildcat


\_\_\_\_\_ FT. FROM N. LINE

\_\_\_\_\_ FT. FROM S. LINE

\_\_\_\_\_ FT. FROM E. LINE

\_\_\_\_\_ FT. FROM W. LINE

C NE NE

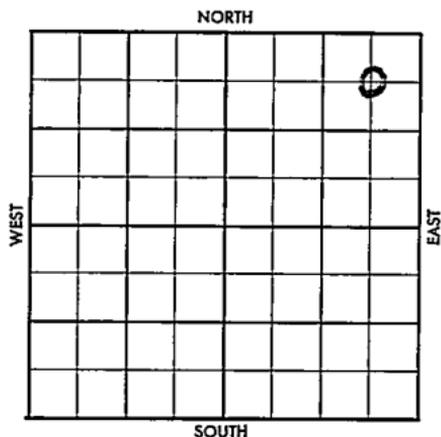

SDX-1 Mile Phillips & Pan-Am--DHM

Westhoma, FO

1957	ELEVATION	REPORT
------	-----------	--------

6/12

Somm. 6-7-57  
13" @ 565/500

Miss. Test  
(FR Tkt)

# WILDCAT

FORM 513 SUNRAY

County Meade Elev. \_\_\_\_\_  
 Sec. 14 Twp. 31 Rgs. 30W  
 Company Thomas & Brewer & Alamo Corp.  
 Farm Name J. H. Borth No. 1

TOPS	DEPTH	LOG	DATUM
Anb.			
Tp.			
H.			
Tr.			
Dg.			
Bl.			
L.			
K.C.			
B.K.C.			
Ce.			
C.			
M.			
M.			
K.			
Mz.			
Mo.			
V.			
S.			
S.			
A.			
R.			
PE.			
G.			
T.D.			

Loc. in Sec. \_\_\_\_\_  
C NE NE  
(Miss Test.)  
 Geol. \_\_\_\_\_  
 Contr. \_\_\_\_\_  
Rine Drlg.  
 Pool \_\_\_\_\_  
Wildcat

FIRST REPORT

JUN 12 1957

1 mile

Date Comm. 6-7-57 Phillips & Pan Am (DHM)  
13" @ 565/500, stuck @ 1563 -- Westhoma (FO)

35

See 1 & 2

M.M

Co.

Lse.

No.

Sec.

T.

R.

