


Section 14 Township 31 Range 32 W

Well No. # 1 E. Clark

Company Skelly Oil

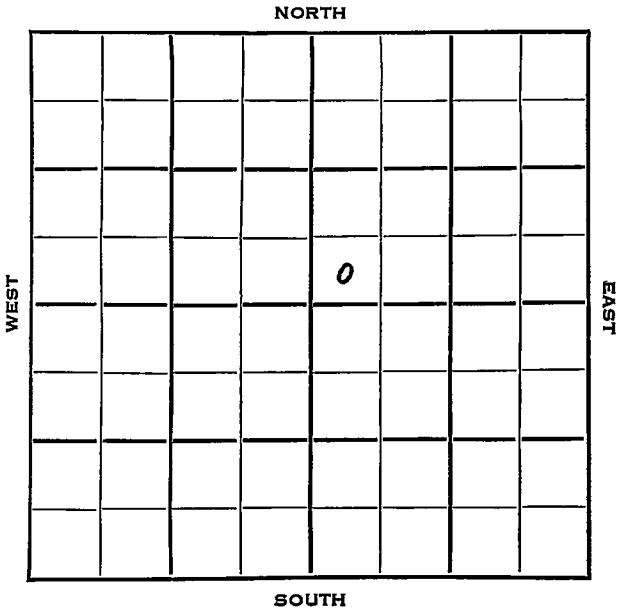

Sec. 14 Twp. 31 R. 32WWell No. #1 E. Clark FarmSkelly Oil CompanyFlourney & Hastin ContractorHugoton Pool


\_\_\_\_\_ Ft. from N. Line

330 Ft. from S. Line

\_\_\_\_\_ Ft. from E. Line

330 Ft. from W. Line

SW SW NE

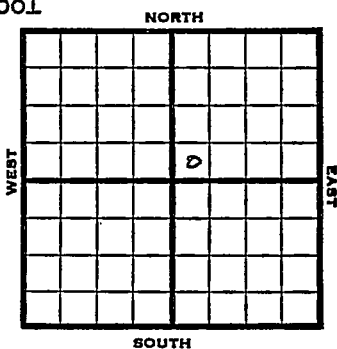

1953 Elev. 2846' REPORT

6/3	Loc.
6/10	"
6/24	10" @ 705 RTD 2625 Schl 7" @ 2598 Her 2598 Up Kr 2619
7/1	NR
7/8	CO 2625 DD 2682 Sd-a-frac. 1500 A DD 2719 PB 2710 5" liner 6000 A
7/22	3000 A
8/5	N.R.
8/19	Spud 6-15-53 Gas Well TD 2719 10" @ 705 Her 2598, Kri 2619, TD 2625 7" @ 2598 DD 2682 Sd-a-frac, 1500A, DD 2719, PB 2710 5" liner 6000A, 3000A, 3000A Win 2715 Comp. 3,440,000 gas

**COMPLETED**



