

Seward

KANSAS

SECTION 14 TOWNSHIP 31S RANGE 33W

WELL NO. #2-Angell Gas Unit "A"


COMPANY Pan-American Petr. Corp.

NORTH

C SW/4

WEST

EAST

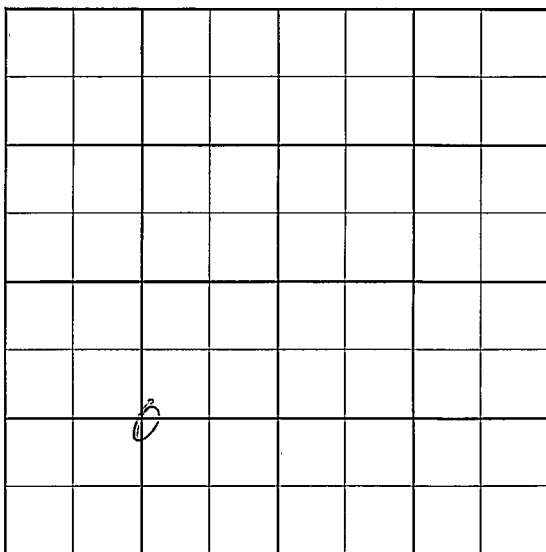

SOUTH

County Seward Elev. _____
 Sec. 14 Twp. 31 Rge. 33W
 Company Pan-American Petroleum Corp.
 Farm Name Angel Gas Unit "A" No. 2

Co.

Lse.

T

No.

Sec.

T.

R.

TOPS	DEPTH	LOG	DATUM
Anh.			
Tr.			
H. <u>Herr.</u>	<u>2621</u>		
Tr. <u>Kerr.</u>	<u>2651</u>		
Dg. <u>Win.</u>	<u>2693</u>		
Bl.			
L.			
K.C.			
B.K.C.			
Ce.			
C.			
M.			
M.			
K.			
Mz.			
Mo.			
V.			
S.			
S.			
A.			
R.			
Pe.			
G.			
T.D.			

Loc. in Sec. _____

C SW/4

Geol. _____

Contr. _____

Barbour

Pool _____

Hugoton

FIRST REPORT

JUL 10 '57

Date Comm. 6-21-578" @ 611/200 5" @ 2701/800CO to 2707 CO 2690 20/ 2664-6620/ 2676-78 frac ga. 2,509 mcfg6 gwph ga. 2051 mcfg, 17 gwph/36 hr.PB 2645 18/ 2632-40 frac CO 2690ga. 2,015 mcfg, 164 gwph/ 16 hr.

County Seward Elev. 2880 DF
 Sec. 14 Twp. 31 Rgs. 33W
 Company Pan-American Petroleum Corp.
 Farm Name Angell Gas Unit "A" No. 2

TOPS	DEPTH	LOG	DATUM	Loc. in Sec.
Anh.				C SW/4
Tp.				
H. <u>Herr.</u>	<u>2624</u>			
Tr. <u>Kri.</u>	<u>2664</u>			
Dg. <u>Win.</u>	<u>2698</u>			
Bl.				
L.				Geol.
K.C.				
B.K.C.				Contr.
Ce.				<u>Barbour</u>
C.				
M.				Pool
M.				<u>Hugoton</u>
K.				
Mz.				
Mo.				
V.				
S.				
S.				
A.				
R.				
Pe.				
G.				
T.D.				

COMPLETE

JUL 24 '57

Date Comm. 6-21-57

8" @ 614/200 5" @ 2701/800

CO to 2707 CO 2690 20/ 2664-66

20/ 2676-78 frac ga. 2,509 mcfg

6 gwph ga. 2051 mcfg, 17 gwph/36 hr.

PB 2645 48/ 2632-40 frac CO 2690

ga. 2,015 mcfg, 164 gwph/ 16 hr.

17 58

PB 2650 /4 CO 2690 ga

1.802 MCFG Thro CSG. JUL 24 '57

24-20 ga 3,840 MCFG 51P 348H