

(WH7-DC67) ✓


Summer

KANSAS

SECTION 14 TOWNSHIP 31 RANGE 2W

WELL NO. #1 Renn

COMPANY Prod. Pipe Supply

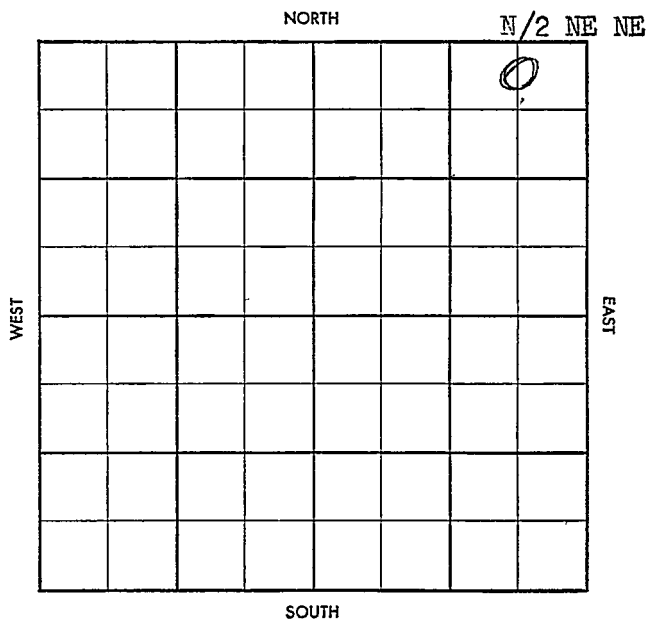

SEC. **14** T. **31 S** R. **2 W**

WELL NO. **#1 Renn** FARM

COMPANY **Producers Pipe & Supply Co.**

CONTRACTOR **Novak Tools**


Wildcat

330 FT. FROM N. LINE

FT. FROM S. LINE

740 FT. FROM E. LINE

FT. FROM W. LINE

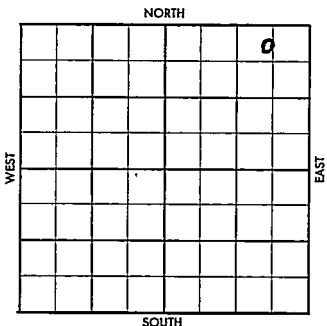

of Sec.

~~NE~~ **NE NE**

SDX-DHC-\$3500.00 (Lse S-20994)

1957 ELEVATION **1294'** REPORT (WH7-DC67) ✓

9/11 Simpson formation appx 4250'
To be commenced by November 1, 1957
To be completed by December 1, 1957
(See DHC Agrt 9-11-57)

10/23 Location (FR Tkt)

11/20 Spud 10-27-57
8" @ 238/180
Miss. 3790'
Back tops: Lsg. 3113', Porosity Zn
3247-58', no show, K 4152', Simp 4211'
Simp Sd 4218', no shows.
Lost circ. & pipe stuck @ 4244'
TD 4340' Ran log
Log tops: Lsg 3106', M. 3780' Simp
Sh 4153', Simp Sd 4212' Arb. 4318'
Log TD 4340' D & A
(See Scout Comp. Ticket)

ABANDONED

12/11 (Advised Contract Section- D & A) ✓

313-A

name

ELEV. 12940

NOV 20 1957

SEC 14

TWP 31

RGE. 2W

COMPANY

Procu.

No. 1

ABANDONED

(SOX-DHM)

FARM Penn

LOC. 1/2 NW NE

(WH7-DC67)

Log tops

Log 3106

M 3780

SSH 4153

SSD 4212

Arb 4318

LTD 4340

GEOL.

CONTR. Novak Wells

POOL. Little t

SPUD. section 30' 57"

φ 360

8" 23 8/180 φ

φ 2376

~~MISS 3790~~ φ 4147

X BACK TOPS

Log 3113 porosity zone 3247-58

Noshov K 4152 Simp 4211 ~~Arb~~

~~Arb~~ ~~TD~~ ~~4210~~ Simp SD 4218

Noshovs ~~4242~~ Loss circu
lation & pipe stuck at 4244 TD

4340 ran log Log tops

D6A

CO.

SE.

NO.

SEC.

TWP.

RGE.