

DX 78-1

Section 14 Township 31 Range 9NWell No. 1 MorrisCompany Aurora Gasoline

NORTH

WEST

EAST

							0

SOUTH

Harper KANSAS

SEC.	TWP.	R.
14	31	9W
WELL NO.		
1 Morris		FARM
COMPANY		
Aurora Gasoline		
CONTRACTOR		

Berwick

Wildcat


_____ Ft. from N. Line

330 _____ Ft. from S. Line

330 _____ Ft. from E. Line

_____ Ft. from W. Line

SE SE SE

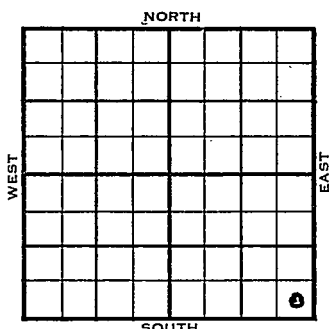

Superior - DHM

	ELEVATION	REPORT
1954	1623'	
7/14	Spud 7-7-54 8" @ 157' Drlg. 3170'	
7/21	Heeb 3439 Tor 3461 B Oread 3480 Doug 3526 DST 3530-3620 7 mins 2880' wtr 1360# Lans. 3639 Miss 4369 EST 4372-94	
9/1	Spud 7-7-54 - Oil Well TD 4500' 8" @ 157' Heeb 3439', Tor 3461', B Oread 3480', Doug. 3526' DST 3530-3620', opn 70", rec. 2880' wtr, 1360# Lans 3639', Miss 4369' DST 4372-94', opn 1 hr., 1,600,000 cfg, 122' mud, 1660# DST 4396-4416', opn 2 hrs., rec. 540' oil, 345' mco, 15' mud, 1770# DST 4418-36, opn 2 hrs., rec. 190' o&gem, 50' mud, 1260# TD 4500' 5" @ 4500' 24/4398-4404, F/ 1-3/4 boph	

(Information Brought Forward)

1954
9/1

Sd-frac


F/53 boph 2 hrs.

F/30 boph

F/40 boph 3 hrs.

Comp. 921 bopd 5% wtr.

COMPLETED

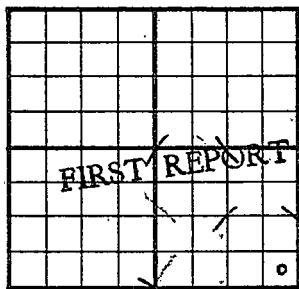County **Harper** State **Kansas**Sec. **14** (Blk. Twp.) **31** (Sur. Rge.) **9W** Map No.Operator **Aurora Gasoline**Well No. **1** Farm **Morris**Elev. Location **SE SE SE**330 Ft. From **S** Line **SE**330 Ft. From **E** Line QuarterIst. Report **JUL 14 1954**


Completion

Remarks **Superior - DEM****Berwick - Contr.**Spudding Date **7-7-54**Drlg. Data **Wildcat****8" @ 157 drlg. 3170****J. G. McGEHEE**

JUL 15 1954

Scout Cards	10
Land Small Map	
Land Wall Map	5
Tracings	
France Map	
Pierce Map	
Misc.	

County Harper State Kansas
 Sec. 14 (Blk.) 31 (Sur.) 9W Map No. _____
 Operator Aurora Gasoline
 Well No. 1 Farm Morris
 Elev. 1623 Location SE SE SE

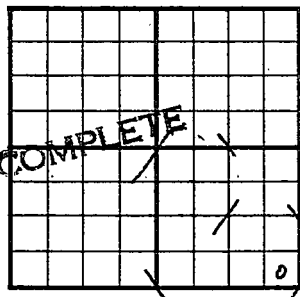

330 Ft. From S Line SE
330 Ft. From E Line Quarter
 Ist. Report _____
 Completion SEP 1 1954
 Remarks Wildcat
Berwick - Contr.
 Spudding Date 7-7-54

Drlg. Data Oil well TD 4500
8" @ 157 Heeb. 3439 Tor. 3461
B. Oread 3480 Doug. 3526 DST 3530-3620
open 70 min. Rec. 2880' wtr. 1360#
Lans. 3639 Miss. 4369 DST 4382-94
open 1 hr. 1,600,000 cfb 122' mud
1660# DST 4396-4416 open 2 hr. Rec.
540' oil 345' mco 15' mud 1770#
DST 4418-36 open 2 hr. Rec. 190' o &
gcm 50' mud 1260# TD 4500 5" @
4500 24/ 4398-4404 F/ 1 3/4 boph
sd-frac F/ 53 boph 2 hr. F/ 30 boph
F/ 40 boph 3 hr. Comp. 921 bopd 5% wtr.

FABEN GILSTRAP

Scout Cards	_____
Land Small Map	_____
Land Wall Map	_____
Tracings	_____
France Map	_____
Pierce Map	_____
Misc.	_____

SEP

8 1954

Orig. Date