

DX 78-1

Harper


KANSAS

Section 14 Township 31 Range 9 W

Well No. # 2 Morris

Company Aurora Gasoline

NORTH

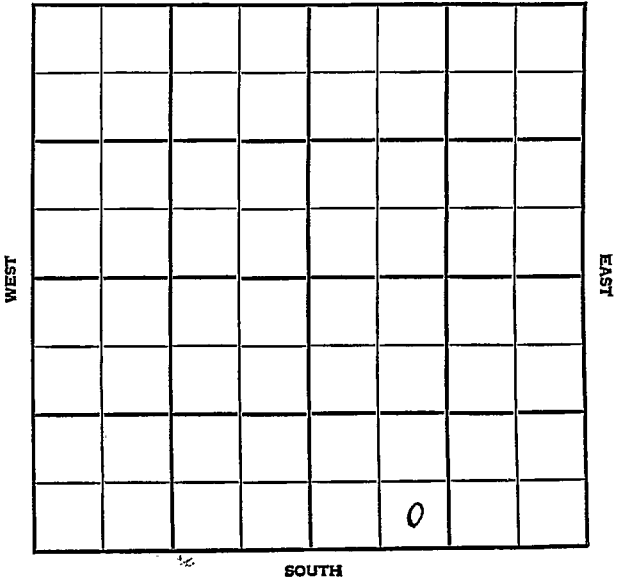

Harper KANSAS

SEC.	TWP.	R.
14	31	9W

WELL NO. **2 Morris** FARM

COMPANY **Aurora Gasoline**

CONTRACTOR **Berwick**


W. Grabs Pool

_____ Ft. from N. Line

330 _____ Ft. from S. Line

_____ Ft. from E. Line

990 _____ Ft. from W. Line

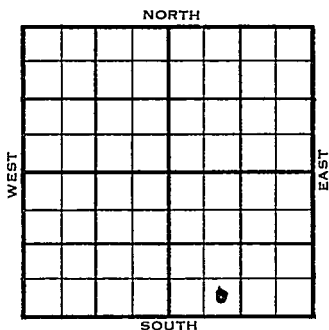

SE SW SE

	ELEVATION	REPORT
1954	1597'	

11/10 MIR

1955
1/19

Spud 11-10-54 Oil well TD 4470
 8" @ 160 Heeb 3423 KC 3615
 Miss. 4343
 DST 4340-66, open 15 min gas in 1½ min
 2,830,000 CFG, 145' GCM 1420#
 DST 4368-92 open 1 hr gas in 8 min
 60' HOCM, 210' oil 1320#
 DST 4396-4414 open 1 hr, gas in 38 min
 rec 90' oil, 140' OCM, 10' wtr.
 840# TD 4470 5" @ 4470 CO to 4430
 36/4373-81 S/18 GOPH 16 hr. frac.
 250 M-A 46/4373-81 frac Hydrofrac.
 60/4373-81 B/½ ~~BBB~~ BOPH 400,000
 CFG 250 M-A Sd-oil-frac.
 Comp. 256 BOPD

COMPLETED.

