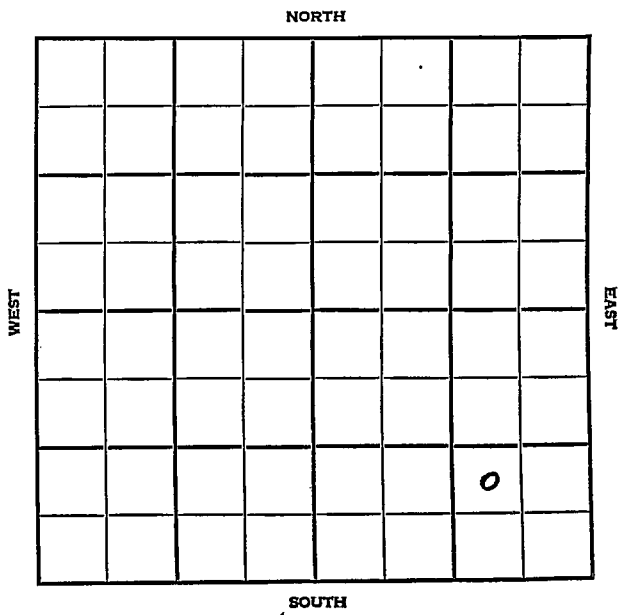


Section 14 Township 31 Range 9WWell No. 3 MorrisCompany Aurora Gasoline

Harper KANSAS

SEC.	TWP.	R.
14	31	9W

WELL NO.

3 Morris

FARM

COMPANY

Aurora Gasoline

CONTRACTOR

Berwick

W. Grabs Pool

Ft. from N. Line


990

Ft. from S. Line

990

Ft. from E. Line

Ft. from W. Line

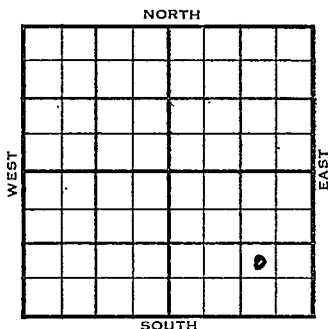

NW SE SE

1954

ELEVATION
1614'

REPORT

11/17

C&P

1955.

1/19

Spud 11-26-54 Oil well TD 4500'
8" @ 187 Miss 4363
DST 4363-81 open 1 hr gas in 5 min
rec 62' GCM 1440#
DST 4382-4407 open 1 hr gas in 5 min
139,000 CFG, rec 120' O & GCM
1800#
DST 4410-30 open 1 hr rec 600' gas,
180' O & GCM, 30' wtr. 900#
TD 4500' 5" @ 4500 Go to 4499
40/4388-98 frac F/1½ BOPH
Comp. F/334 BOPD

COMPLETED

County Harper State Kansas
 Sec. 14 (Blk.) 31 (Sur.) 9W Map No.
 Operator Aurora Gasoline
 Well No. 3 Farm Morris
 Elev. 1614 Location NW SE SE


990 Ft. From S Line SE
 990 Ft. From E Line Quarter
 1st. Report NOV 17 1954
 Completion
 Remarks
Berwick - Contr.
 Spudding Date

Drlg. Data

W. Grabs PoolCellar & pits

FABEN GILSTP

County Harper State Kansas
 Sec. 14 (Blk. 31) (Sur. 9W) (Twp.) (Rge.) Map No.
 Operator Aurora Gasoline
 Well No. 3 Farm Morris
 Elev. 1614 Location NW SE SE

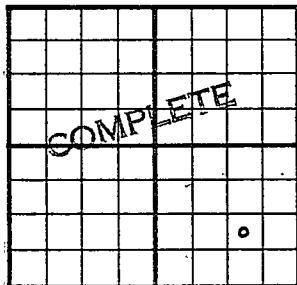

990 Ft. From S Line SE
990 Ft. From E Line Quarter
 1st. Report
 Completion JAN 1 9 1955
 Remarks W. Grabs Pool
Berwick - Contr.
 Spudding Date 11-26-54

Drlg. Data Oil well TD 4500
8" @ 187 Miss. 4363 DST 4363-81
open 1 hr. gas in 5 min. Rec. 62' gcm
1440# DST 4382-4407 open 1 hr. gas in
5 min. 139,000 cfg Rec. 120' o & gcm
1800# DST 4410-30 open 1 hr. Rec.
600' gas 180' o & gcm 30' wtr. 900#
TD 4500 5" @ 4500 CO to 4499
40/ 4388-98 frac F/ 1 1/2 boph
Comp. F/ 334 bopd

FABEN GILSTRAP