


WELL LOG BUREAU - KANSAS GEOLOGICAL SOCIETY 5-31-15W
 508 East Murdock, Wichita, Kansas

Company- JONES, SHELburnE & FARMER, INC.
 Farm- Moad No. 1

SEC. 5 T. 31 R. 15W
 NE NE NW

Total Depth. 4920
 Date 6-16-56 Comp. 7-7-56
 Shot or Treated.
 Contract No.
 Issued. 7-28-56

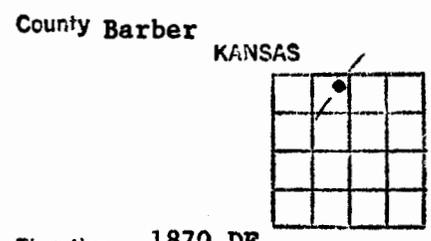

CASING:
 8 5/8" 835' cem w/350 sx

Elevation. 1870 DF

Production. Dry

Figures indicate Bottom of Formations.

surface redbed, gyp	40
rock	110
redbed, shale, shells	460
shale	730
anhydrite	835
red rock, shale	1040
salt shale, shells	1220
shale, shells	1410
shale, lime	2020
lime	2800
lime, shale	3405
lime	3564
sand, shale	3676
lime	3770
sand	3821
lime, shale	3891
sand, shale	3978
shale sdy	4040
lime	4627
lime (cherty)	4666
lime	4700
lime (cherty)	4713
lime & chert	4762
lime	4836
sand, shale	4886
arbuckle	4920
Total Depth	

Tops:

Anhydrite	730
Heebner (Electric Log)	3829
Douglas "	3892
Brown lime "	4008
Lansing "	4034
Massey "	4470
Mississippi "	4580
Misner "	4641
Viola "	4645
Simpson "	4810
Arbuckle "	4898

T.D. electric log 4933