

DX 78-1

Barber


KANSAS

Section 15 Township 31 Range 10W

Well No. #1 Stone

Company Musgrove Pet.

NORTH

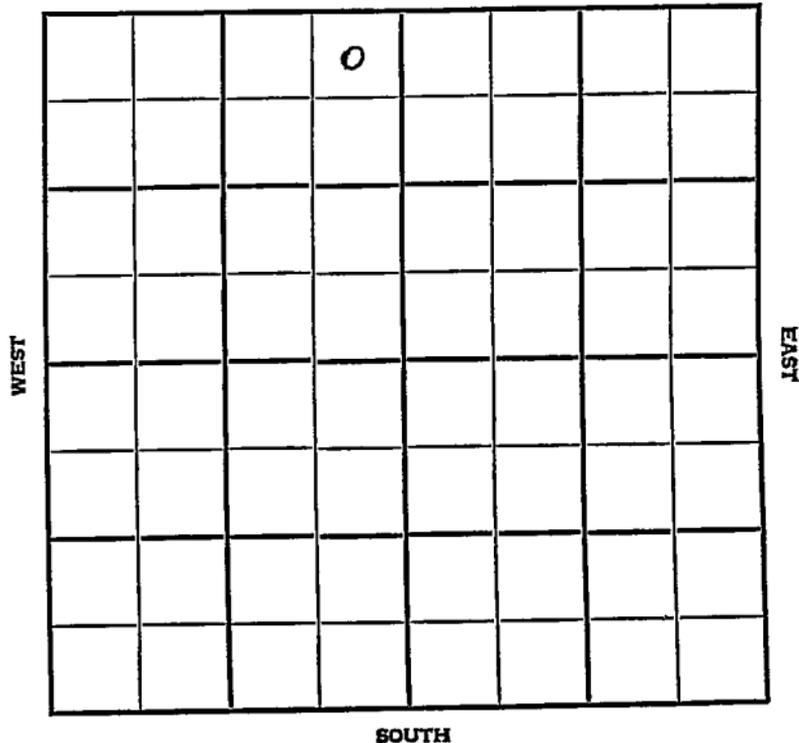

SOUTH

SEC.	TWP.	R.
15	31	10w

WELL NO. **1 Stone** FARM

COMPANY **Musgrove Petroleum**

CONTRACTOR **Arb**
Wildcat


330' Ft. from N. Line

Ft. from S. Line

330' Ft. from E. Line

Ft. from W. Line

NE NE NW

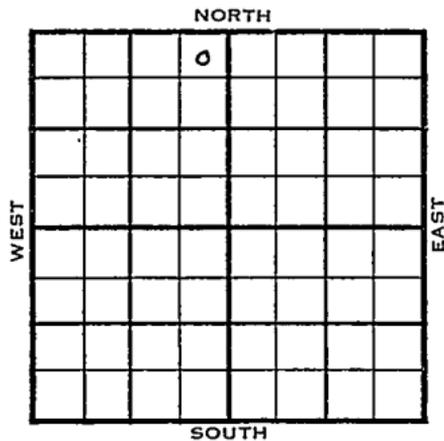

Arb Test

Magnolia AC contribution

	ELEVATION	REPORT
1955	1743	

6/1 Location

6/29 Comm 8-6-55

Tp Elgin 3472 3472

H 3644 3646

Dg 3686 3688

L 3847 3850

KC Penn 4495

M 4507 4504

K 4666 4674

V 4783 4785

Sd 4875 4877

A 4969 4971

TD ~~4200~~ 5000

8 5/8" @ 322/175 DST 3685-96 open

1 hr. Rec 120' ho & Gcwm 60' sw

1195/20" DST 4493-4505 failed

DST 4493-4522 open 1 1/4 hr. Rec 95'

mud 165/30" DST 4506-45 failed

D & A

ABANDONED

County Barber Elev. 1743
 Sec. 15 Twp. 31 Rge. 10W
 Company Musgrove Pet.
 Farm Name Stone No. 1

TOPS	DEPTH	LOG	DATUM
Anh.			
Tp. <u>E/gin</u>	<u>3472</u>	<u>3472</u>	<u>1729</u>
H.	<u>3644</u>	<u>3646</u>	<u>1903</u>
Tr.			
Dg.	<u>3686</u>	<u>3688</u>	<u>1945</u>
Bl.			
L.	<u>3847</u>	<u>3850</u>	<u>2107</u>
K.C. <u>Penn</u>	<u>4495</u>		<u>2752</u>
B.K.C.			
Ce.			
C.			
M.	<u>4507</u>	<u>4504</u>	<u>2761</u>
M.			
K.	<u>4666</u>	<u>4674</u>	<u>2931</u>
Mz.			
Mq.			
V.	<u>4783</u>	<u>4785</u>	<u>3042</u>
S. <u>sd</u>	<u>4875</u>	<u>4877</u>	<u>3134</u>
S.			
A	<u>4969</u>	<u>4971</u>	<u>3228</u>
R.			
Pe.			
G.			
Tp.	<u>5000</u>		

Loc. in Sec.

NE NE NW

Geol.

Contr.

Pool

Wildcat

ABANDONED

Date Comm. 8-6-55

JUN 29 1955

8 5/8" @ 322/175 DST 3685-95 open1 hr. Rec. 210' ho & gcwm 60' sw1195/20" DST 4493-4505 failedDST 4493-4522 open 1 1/2 hr. Rec. 95' mud165/30" DST 4506-45 failed

D & A