


Section 15 Township 31 Range 14W

Well No. 1 Skinner

Company Coppinger & Southern

Skinner Pool

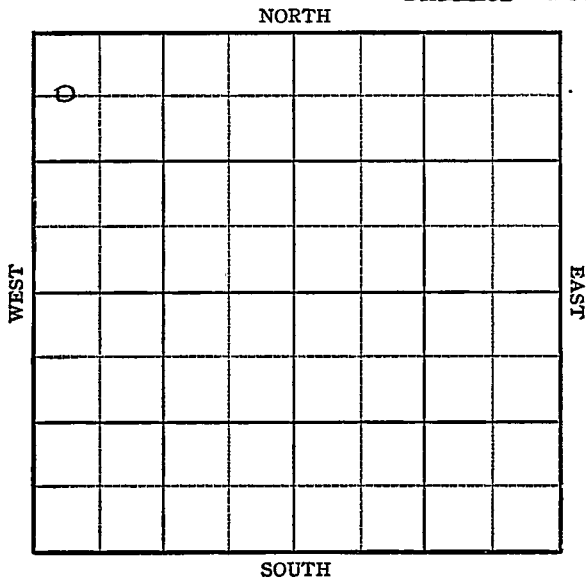

KANSAS

Barber

Sec. 15 Twp. 31 R. 14W ✓

Well No. #1 Skinner Farm

Coppinger & Southern

Company

Skinner Pool


660' Ft. from N. Line

 Ft. from S. Line

 Ft. from E. Line

330' Ft. from W. Line

C W L NW NW

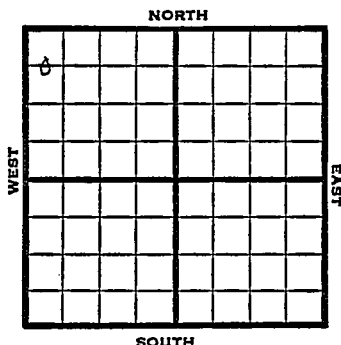

1948	Elev 1618'	REPORT
12/15	13" @ 101'	
12/22	8" @ 780'	
	Drlg. 2600'	
12/29	Lansing 3759'	
	Drlg. 4085'	
1949		
1/12	TD 4537'	
	Douglas 3648'	
	Maguoketa 4348'	
	Viola 4382'	
	Simp 4501'	
	band.	
	ABANDONED	

Map No. _____ Sec. 15 Twp. 31 R. 14W

Well No. 1 Skinner

Coppinger & Southern Company

FIRST REPORT

C W L NW NW Contractor


SECTION PLAT

660 Ft. from N. Line

_____ Ft. from S. Line

_____ Ft. from E. Line

330 Ft. from W. Line

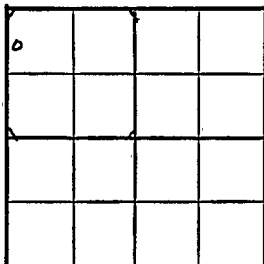

Barber County

Location _____

Rig up _____

Drilling and Remarks:

13" @ 101

RECORD

Cased _____ in., _____ ft.

Sand _____

Gas _____

Oil _____

Total Depth _____

PRODUCTION

1st 24 hrs. Nat. _____

1st 24 hrs. after shot _____

Gas _____ Cu. Ft.

Dry Hole _____

Abandoned _____

Date

DEC 15 1948

S. J. LEWIS

Scout


Map No. 93 Sec. 15 Twp. 31 R. 14WWell No. 1 SkinnerCoppinger & Southern Company**ABANDONED**

Contractor

C W L NW NW

E. 16/8
SECTION PLAT660 Ft. from N. Line Ft. from S. Line Ft. from E. Line330 Ft. from W. Line

Barber County

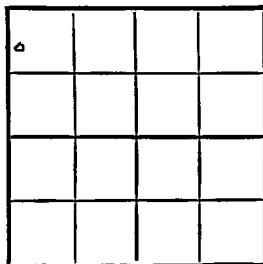

RECORD

Location Cased in., ft.Rig up Sand

Drilling and Remarks:


PRODUCTION

1st 24 hrs. Nat. 1st 24 hrs. after shot Gas Cu. Ft.Dry Hole Abandoned

Date

JAN 12 1949 19

S. J. LEWIS

Scout