


KANSAS

Stevens

Section 15 Township 31 Range 37WWell No. 1 ThurowCompany Hugoton Prod.

Hugoton

NORTH

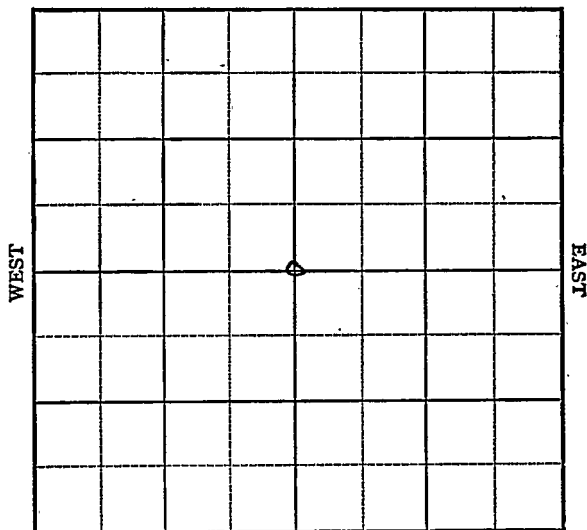

SOUTH

KANSAS

Stevens

Sec. 15 Twp. 31 R. 37W

Well No. #1 Thurow Farm

Hugoton Prod. Company

Hugoton Pool


2640' Ft. from N. Line

Ft. from S. Line

2640' Ft. from E. Line

Ft. from W. Line

C Sec.

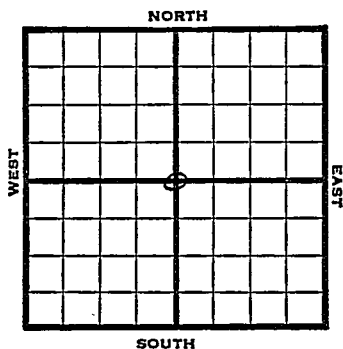

1949

Elev 3084'

R E P O R T

3/9 Drlg. 533'

3/16 10" @ 525'
TD 2522'
7" @ 2501'

3/23 "

3/30 TD 2760'

4/6 "

4/12 281' of 5" Perf liner @ 2764' TD

4/20 "

4/27 "

5/4 "

5/10 "

5/38 "

5/25 "

6/1 "

6/7 "

6/15 "

6/21 "

6/29 TD 2764'

7" @ 2501'

281' of 5" Perf Liner @ 2764'

4,301,000 Gas

429# R Pr.

Comp

COMPLETED

Map No. _____ Sec. 15 Twp. 31 R. 37W

Well No. 1 Thurow

Hugoton Prod. Company

FIRST REPORT

Contractor

C Sec.


SECTION PLAT

2640 Ft. from N. Line

_____ Ft. from S. Line

2640 Ft. from E. Line

_____ Ft. from W. Line

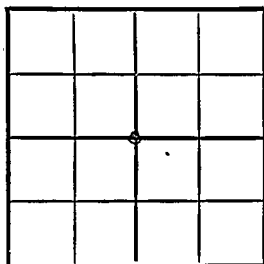

Stevens County

RECORD

Location _____

Cased _____ in. _____ ft.

Rig up _____

Sand _____

Drilling and Remarks:

Gas _____

Drilg. 533

Oil _____

Total Depth _____

PRODUCTION

1st 24 hrs. Nat. _____

1st 24 hrs. after shot _____

Gas _____ Cu. Ft.

Dry Hole _____

Abandoned _____

Date

MAR 9 1949

19

S. J. LEWIS

Scout

Map No. _____ Sec. 15 Twp. 31 R. 37W

Well No. 1 Thurow

Hugoton Prod. _____ Company

COMPLETE

Contractor

C Sec.

E1, 3084


SECTION PLAT

2640 Ft. from N. Line

_____ Ft. from S. Line

2640 Ft. from E. Line

_____ Ft. from W. Line

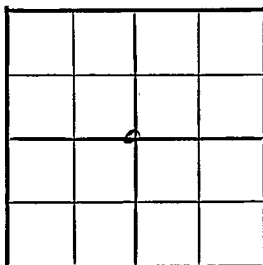

Stevens County

Location _____

Rig up _____

Drilling and Remarks:

7" @ 250'

281' of 5" Pay line

@ 2764

4, 351, 000 Gas

429 # R 12

RECORD

Cased _____ in., _____ ft.

Sand _____

Gas _____

Oil _____

Total Depth 2764

PRODUCTION

1st 24 hrs. Nat. _____

1st 24 hrs. after shot _____

Gas _____ Cu. Ft.

Dry Hole _____

Abandoned _____

Date

JUN 29 1949

19

S. J. LEWIS

Scout