


Section 15 Township 31 Range 35-W

Well No. #1 Gaskill

Company Magnolia

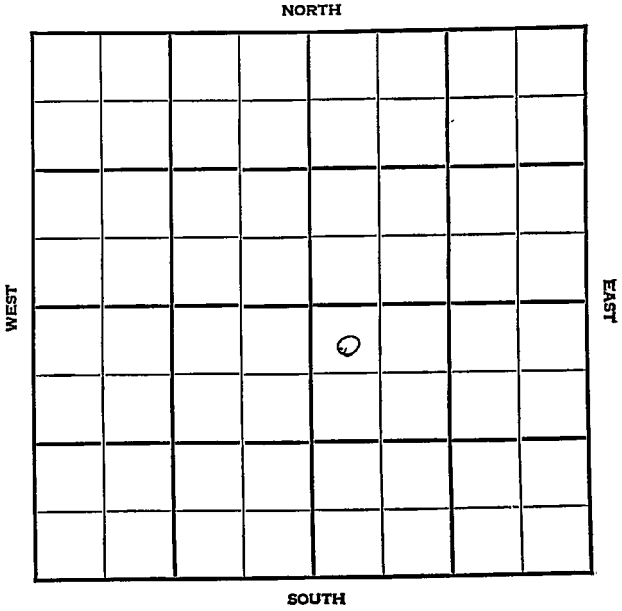



Sec. 15 Twp. 31 R. 35W

Well No. #1 Gaskill Farm

Magnolia Company

Hugoton Pool


330' Ft. from N. Line

_____ Ft. from S. Line

_____ Ft. from E. Line

330' Ft. from W. Line

NW SE

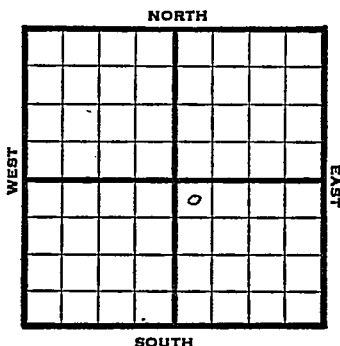

1948

Eli 3002'

REPORT

6/23
6/29
7/14
7/8
7/21
7/28
8/4
8/11
8/18

Location
" "
10" @ 673'
Drlg 2610'
Location
TD 2861
7" @ 2860'
144 shots 2778-2810 7000 acid
96 shots 2724-46 7000 acid
120 shots 2677-2704 7000 acid
72 shots 2642-72 7000 acid
" "
" "
7" @ 2860'
TD 2861'
Perf 38000 acid
8,260,000 gas
395# R Pr.
Comp

COMPLETED

Map No. _____ Sec. 15 Twp. 31 R. 35W

Well No. 1 Gaskill

Magnolia Company

FIRST REPORT

Contractor

NW SE

SECTION PLAT

330 Ft. from N. Line

_____ Ft. from S. Line

_____ Ft. from E. Line

330 Ft. from W. Line

		o	

Stevens County

Location X

Rig up _____

Drilling and Remarks:

RECORD

Cased _____ in. _____ ft.

Sand _____

Gas _____

Oil _____

Total Depth _____

PRODUCTION

1st 24 hrs. Nat. _____

1st 24 hrs. after shot _____

Gas _____ Cu. Ft.

Dry Hole _____

Abandoned _____

Date

JUN 23 1948 19 _____ S. J. LEWIS Scout

Stevens County Kansas State

Map No. _____ Sec. 15 Twp. 31 R. 35W

Well No. 1 Gaskill

Magnolia Company

COMPLETE

Contractor

E. J. 3002

SECTION PLAT

"NW SE

330 Ft. from N. Line

_____ Ft. from S. Line

_____ Ft. from E. Line

330 Ft. from W. Line

Hugoton Pool

Remarks:

7" C2820

7052861

Prof

35000000

8, 260, 000 Gas

395-R/A

Date

AUG 1 8 1948

Scout

S. J. LEWIS