


Section 15 Township 31 Range 33W

Well No. 1 Collingwood G. U. "H"

Company Stanolind O&G

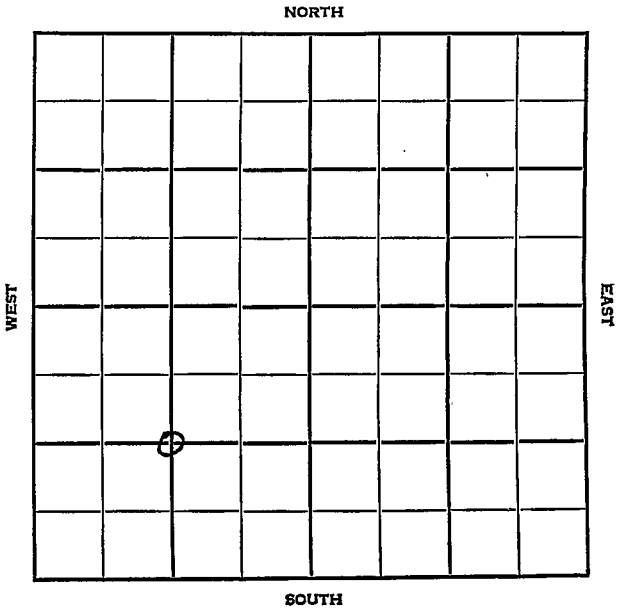

Seward KANSAS

SEC. 15	TWP. 31	R. 3 3W
------------	------------	------------

WELL NO. 1 Collingwood G. U. "H" FARM

COMPANY Stanolind O&G

CONTRACTOR


Hugoton Pool

_____ Ft. from N. Line

1320 _____ Ft. from S. Line

_____ Ft. from E. Line

1320 _____ Ft. from W. Line

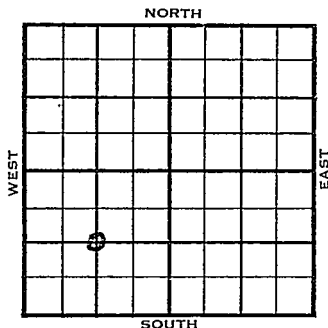

C SW/4

1954	ELEVATION 2892'	REPORT
------	--------------------	--------

9/22 Location

11/23 Spud 10-13-54 - Gas Well
 TD 2724'
 8-5/8" @ 611'
 Her. 2608', Kri 2649', Win 2688'
 TD 2724'
 5" @ 2688'
 CO to 2645'
 126/2611-32, 30/2650-55, 60/2662-72
 dolo-frac
 2,235,000 cfg, 50 gwph
 dolo-frac, 2,646,000 cfg 60 gwph
 7000A 4,282,000 cfg 3000A
 Comp. 9,121,000 cfgpd

COMPLETED

County Seward State Kansas

Sec. 15 (Blk. 31) (Sur. 33W) (Twp.) (Rge.) Map No.

Operator Stanolind

Well No. 1 Farm Collingwood Gas Unit "H"

Elev. 2892 Location C SW/4

1320 Ft. From S Line SW

1320 Ft. From W Line Quarter

1st. Report

Completion NOV 23 1954

Remarks Hugoton Pool

Spudding Date 10-13-54

Drilg. Data Gas well TD 2724

8 5/8" @ 611 Her. 2608 Kri. 2649

Win. 2688 TD 2724 5" @ 2688

C⁰ to 2645 126/ 2611-32 30/ 2650-55

60/ 2662-72 dolo-frac 2,235,000 cfg

50 gawph dolo-frac 2,646,000 cfg 60 gwph

7000 A 4,282,000 cfg 3000 A

Comp. 9,121,000 cfgpd

FABEN GU STRAP