


Section 15 Township 31 Range 16 W

Well No. # 1 Robbins Ranch

Company Kirk Johnson (Ft. Worth Texas)

NORTH

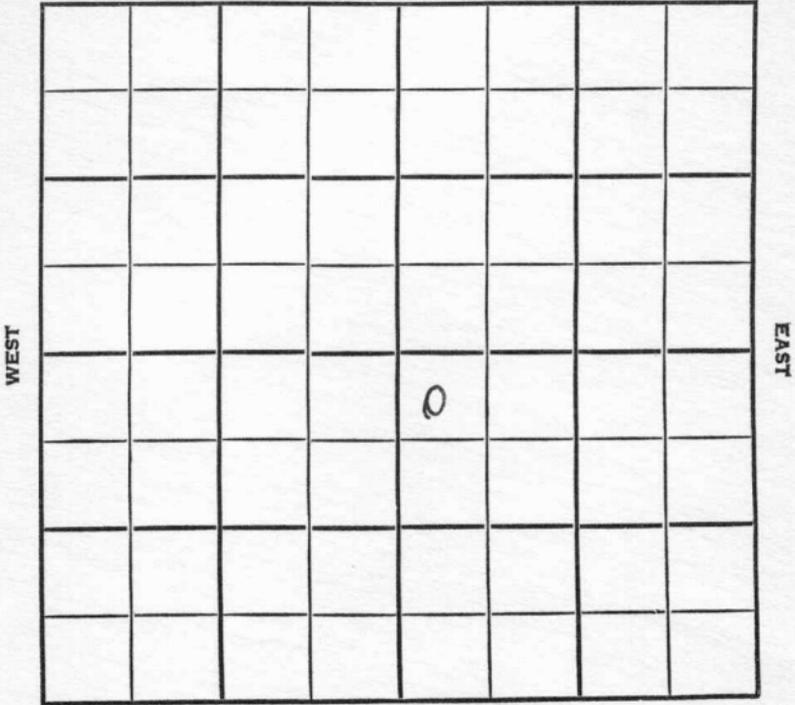

SOUTH

Comanche KANSAS

SEC.	TWP.	R.
15	31	16W

WELL NO.

1 Robbins Ranch

FARM

COMPANY

Kirk Johnson (Ft. Worth, Texas)

CONTRACTOR

Nye & Snell


Wildcat

330 _____ Ft. from N. Line

_____ Ft. from S. Line

_____ Ft. from E. Line

330 _____ Ft. from W. Line

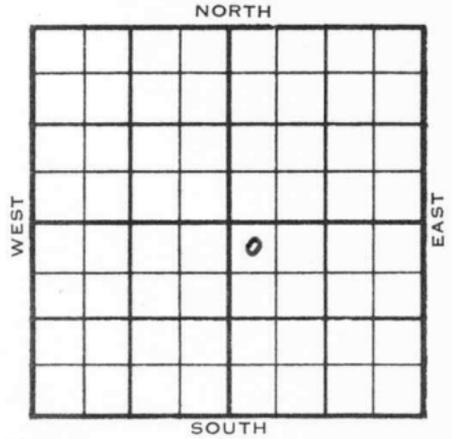

NW NW SE

Barbara Oil FO

	ELEVATION	REPORT
1954	2050'	
11/23	Spud 11-10-54 8" @ 285' Heeb 4133', KC 4315' Brlg. 4630'	
12/1	Spud 11-10-54 D & A TD 5025 8" @ 285 Heeb 4133 KC 4315 Tor. 4150 Doug 4174 B KC 4718 Kamiska 4830 Miss. 4961 DST 4963-71 open 1 hr rec 10' GCM 120# DST 4970-80 open 1 hr rec 70' G & VSOCM, 30' muddy SW 405# TD 5025 D & A	
		ABANDONED


County **Comanche** State **Kansas**

Sec. **15** (Blk. Twp.) **31** (Sur. Rge.) **16W** Map No.

Operator **Kirk Johnson (Ft. Worth, Texas)**

Well No. **1** Farm **Robbins Ranch**

Elev. Location **NW NW SE**

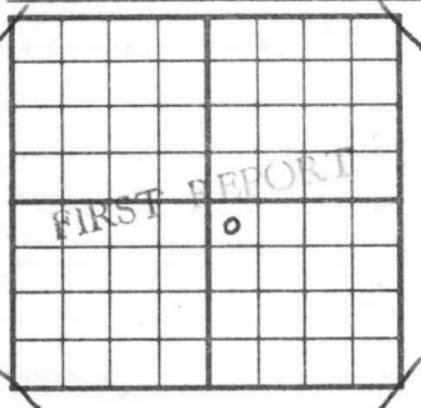

330 Ft. From **N** Line **SE**

330 Ft. From **W** Line Quarter

Ist. Report **NOV 23 1954**

Completion


Remarks **Barbara Oil - FO**

Nye & Snell - Contr.

Spudding Date **11-10-54**

Drlg. Data **Wildcat**

8" @ 285 Heeb. 4133 KC 4315 drlg. 4630

 

FABEN GILSTRAP

Kansas


County **Comanche** State

Sec. **15** (Blk. **31**) (Sur. **16W**) (Twp. **31**) (Rge. **16W**) Map No.

Operator **Kirk Johnson**

Well No. **1** Farm **Robbins Ranch**

Elev. **2050** Location **NW NW SE**

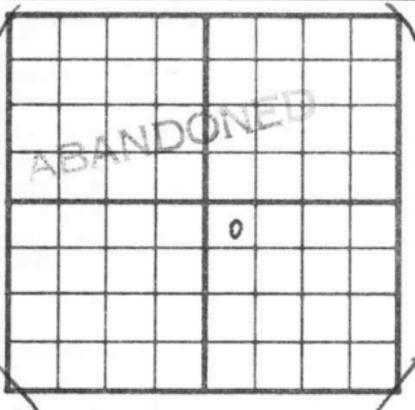

330 Ft. From **N** Line **SE**

330 Ft. From **W** Line **Quarter**

1st. Report

Completion **DEC 1 1954**

Remarks **Wildcat**

Nye & Snell - Contr.

Spudding Date **11-10-54**

Drilg. Data **D & A TD 5025**

8" @ 285 Heeb. 4133 KC 4315

Tor. 4150 Doug. 4174 B KC 4718

Kamiska 4830 Miss. 4961 DST 4963-71

open 1 hr. Rec. 10' gcm 120#

DST 4970-80 open 1 hr. Rec. 70' g &

vsocm 30' muddy sw 405# TD 5025

D & A

FABEN GILSTRAP