DX 78-1

Harper

KANSAS

Section 15 Township 31 Range 9W

Well No. 1 Kennedy

Company Rupp-Ferguson

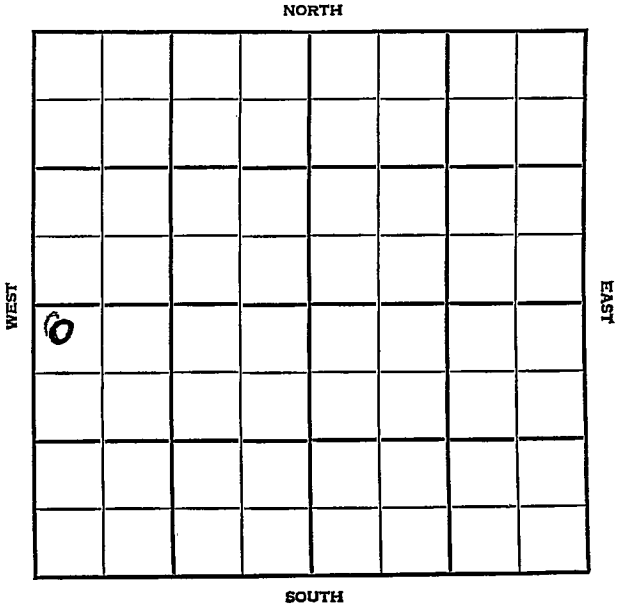

Harper KANSAS

SEC.	TWP.	R.
15	31	9W

WELL NO.

1 Kennedy FARM

COMPANY

Rupp-Ferguson

CONTRACTOR

Co. Tools

Wildcat

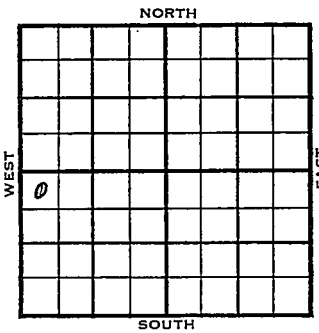

_____ Ft. from N. Line

_____ Ft. from S. Line

_____ Ft. from E. Line

_____ Ft. from W. Line

NW NW SW

1 mi S D-X

1955	ELEVATION 1640	REPORT
6/29		M I R
7/7		Spud 6-28-55 8-5/8" @ 258/225 Drlg. 3412'
7/14		Doug 3572, Lans 3670, Miss. 4391, TD 4550, DST 4391-4406, open 1½ hr. rec 458 mcfg, 55% mud 1580/20" DST 4406-31, open 1 hr. gas in 3 min. 1,300 mcfg 205' oil, 1580/20", DST 4431-56, open 1½hr. rec 35' gcm, 200/20", Drlg 4540.
7/22		5½" @4505, CO, 16/4416-20, 8/4416-20, 500 M-A, 3/4 boph, 300 mcfg, frac
7/28		Rec. load, ga 4,200 mcfg, shut in.
8/3		Camp. shut in gas well, 4,200 mcfgpd Dg½ 3572 1932 L. 3670 2030 M. 4391 2751 TD 4550 COMPLETED

DX-78

FORM 513 REV. SUNRAY

County Harper Elev.

Sec. 15 Twp. 31 Rge. 9W

Company Rupp-Ferguson

Farm Name Kennedy No. 1

TOPS	DEPTH	LOG	DATUM
Anh.			
Tp.			
H.			
Tr.			
Dg.			
B.L.			
L.			
K.C.			
B.K.C.			
Ce.			
C.			
M.			
M.			
K.			
Mz.			
Mc.			
V.			
S.			
S.			
A			
R.			
P€.			
G.			
T.D.			

Loc. in Sec. NW NE SW

Geol.

Contr. Co. tools

Pool Wildcat

FIRST REPORT
1 Mile
JUN 29 '55

Date Comm.

E I R

Co. Lse. No. Sec. T. R.

FORM 513 REV. SUNRAY

County Harper Elev. 1640

Sec. 15 Twp. 31 Rge. 9W

Company Rupp-Ferguson

Farm Name Kennedy No. 1

TOPS	DEPTH	LOG	DATUM
Anh.			
Tp.			
H.			
Tr.			
Dg.	3572		1932
Bl.			
L.	3670		2030
K.C.			
B.K.C.			
Ce.			
C.			
M.	4391		2751
M.			
K.			
Mz.			
Mo.			
V.			
S.			
S.			
A			
R.			
P€.			
G.			
T.D.	4550		

Loc. in Sec. NW NW SW

Geol.

Contr. Co. tools

Pool Wildcat

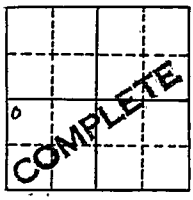

Date Comm. 6-28-55 AUG 3 1955

8 5/8" @ 258/225 DST 4391-4406
open 1½ hr. Rec. 55' mud gas in
4 min. 458 mcfg 1580/20"
DST 4406-31 open 1 hr. gas in 3 min.
1,300 mcfg Rec. 205' oil 1580/20"
DST 4431-56 open 1½ hr. Rec. 35' gcm
200/20" 5½" @ 4505 CO to TD
16/ 4516-20 repef. 8/ 4516-20
500 M-A 3/4 boph 300 mcfg frac
Comp. shut in gas well 4,200 mcfgpd

Co. Lse. No. Sec. T. R.