


Harper

KANSAS

SECTION # 15 TOWNSHIP 31S RANGE 9W

WELL NO. #1 Miller "C"

COMPANY Rupp-Ferguson

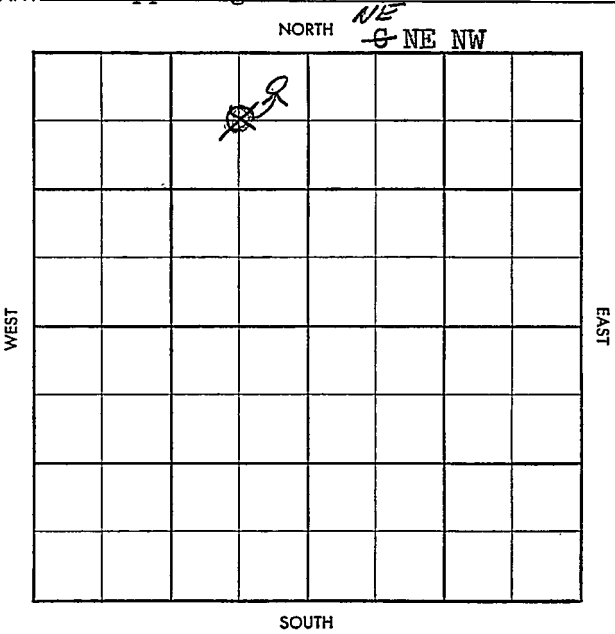

Twp X Pool 1
Co. 1 East 27

5

Use:

Pool _____

Grabs NW

No.

366

	T.
	R.

CORRECTION

Twp. ~~X~~ Pool ~~X~~
 Sec. ~~X~~ East ~~X~~

5-513-B

County Harper Elev. 1652 DF 1655 AB
 Sec. 15 Twp. 31 Rge. 9W
 Company Rupp-Ferguson
 Farm Name Miller "C" No. 1

TOPS	DEPTH	LOG	DATUM
Anh.			
Tp.			
H.			
Tr.			
Dg.		3572	
B.L.			
L.		3672	
K.C.			
B.K.C.		4193	
Ce.			
C.			
M.	4376		
M.			
K.			
Mz.			
Mq.			
V.			
S.			
S.			
A.			
R.			
Pf.			
G.			
T.D.	4440		

Loc. in Sec. NE & NE NW

Geol. Co 1005

Pool Grabs NW

0		
COMPLETE		
JUL 2 '58		

Date Comm. 5-23-58 (Texas - DHM)
4400' Miss Test. Location 8"258

Q 2345 JUN 3 '58 Q 4204 JUN 11 '58 PST
4378-4410 Q 20" ga 2.800 m/f
120' Hgem BHP 1520 5 1/2 4440
CO JUN 18 '58 40/4 392-4402 frac
F10 Ld to ga 3.500 m/f JUN 25 '58
51 JUL 2 '58 KPL op F10 10.367
muf FTP 1267 SITP 1467

+