

Comanche KANSAS


DX 78-1

15-165/DNL

Section N4 Township 31 Range 16W

Well No. 1 Robbins 'C'

Company Barbara Oil

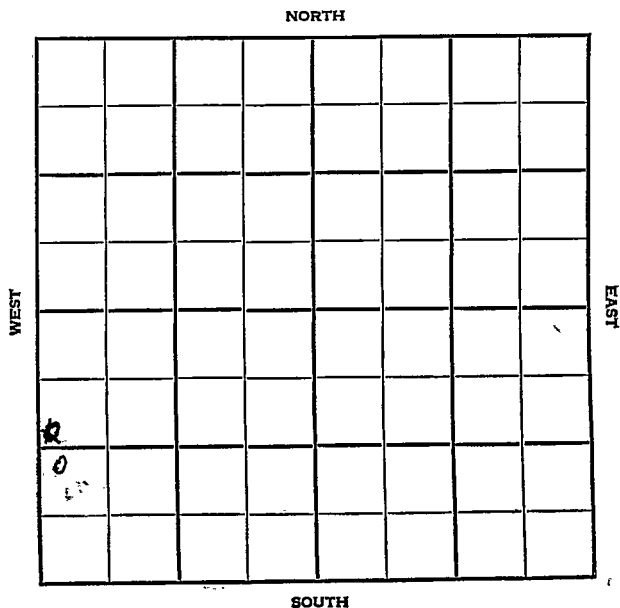

Commanche KANSAS

SEC.	TWP.	R.
14	31	16W

WELL NO.

1 Robbins "C"

FARM

COMPANY

Barbara Oil

CONTRACTOR

Patton Drlg.

Robbins Ranch Pool

Ft. from N. Line


1260

Ft. from S. Line

Ft. from E. Line

120

Ft. from W. Line

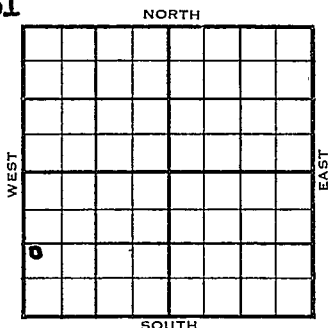

NW SW SW

1954	ELEVATION	REPORT
	2060'	

6/23 Spud 6-17-54

10" @ 310'

Drlg. 2208'

7/7 Heeb 4176 Lans 4364

Drlg. 4795

8-11 Spdg 6-17-54

D&A

TD 4982

10" 310

Heeb 4176 Lans. 4364 Miss. 4977

DST 4978-82 open 1hr. gas in 3 min.

300,000 cfg F/ oil 1 hr. Rec. HFO

1720#


TD 4982

7" @ 4978 CO to 4979 S/ 55 bo 24 bsw

SI 18 hr. HFSW

D&A

ABANDONED

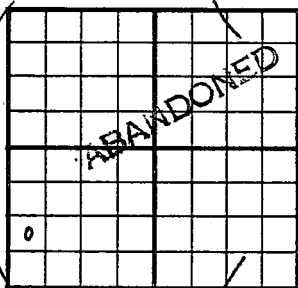County Comanche State KansasSec. 14 (Blk. Twp.) 31 (Sur. Rge.) 16W Map No.Operator Barbara OilWell No. 1 Farm Robbins "C"Elev. 2060 Location NW SW SW

1260Ft. From S Line SW

120Ft. From W Line Quarter

1st. Report

Completion AUG 11 1954Remarks Robbins Ranch Pool
Patton Drlg. - Contr.Spudding Date 6-17-54.Drlg. Data D & A TD 498210" @ 310 Heeb. 4176 Lans. 4364Miss. 4977 DST 4978-82 open 1 hr.gas in 3 min. 300,000 cfg F/ oil 1 hr.Rec. HFO 1720# TD 4982 7" @ 497860 to 4979 S/ 55 bo 24 bsw SI 18 hr.HFSWD & A

72

J. G. McGEHEE