

24-31-16W

KANSAS GEOLOGICAL SOCIETY
KANSAS WELL LOG BUREAU - KANSAS WELL SAMPLE BUREAU
KANSAS GEOLOGICAL SOCIETY BUILDING
508 EAST MURDOCK - WICHITA, KANSAS

COMPANY PETROLEUM INC.

SEC. 24 T. 31 N. 16W

FARM Robbins Ut "B" NO. 1

LOC. APP W½ NE

TOTAL DEPTH 4911'

COMM. 11-30-67


COMP. 12-13-67

SHOT OR TREATED

CONTRACTOR Garvey Drilling

ISSUED 1-13-68

COUNTY Comanche

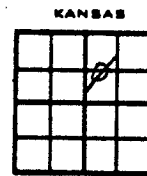

CASINO

20 10
15 8 5/8" 511' cem w/ 350 sx
12 6
13 5


ELEVATION 1975' KB

PRODUCTION DRY? KIND

FIGURES INDICATE BOTTOM OF FORMATIONS

492' Sand, Gravel and Red Bed
965' Red Bed and Shale
1140' Lime and Shale
1710' Red Bed, Shale and Lime
1950' Shale
2420' Lime and Shale
2610' Lime
3355' Lime and Shale
3490' Shale and Lime
3860' Lime and Shale
3939' Lime
4125' Lime and Shale
4190' Shale
4295' Lime and Shale
4565' Lime
4690' Lime and Shale
4740' Lime
4798' Lime and Shale
4911' Lime
4911' RTD

TOPS: LOG
Heebner 4064
Lansing 4228
Heartha 4578
Mississippi 4822
Kinderhook shale 4888

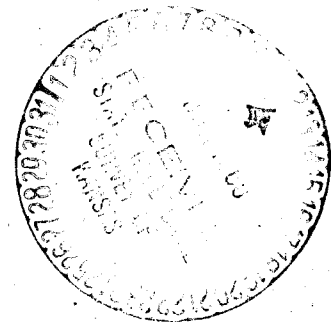

State of Kansas

County of Barton

I, Sam N. Stephens

of

Garvey Drilling Company

upon oath state the above and foregoing is a true and correct copy of the log of the Robbins Unit B-1 well.