

KANSAS


Barber county

FORM 51 5M 6-46 PETROL

Section 16 Township 31 Range 14-W

Well No. #1, Skinner

Company H & T Drilling

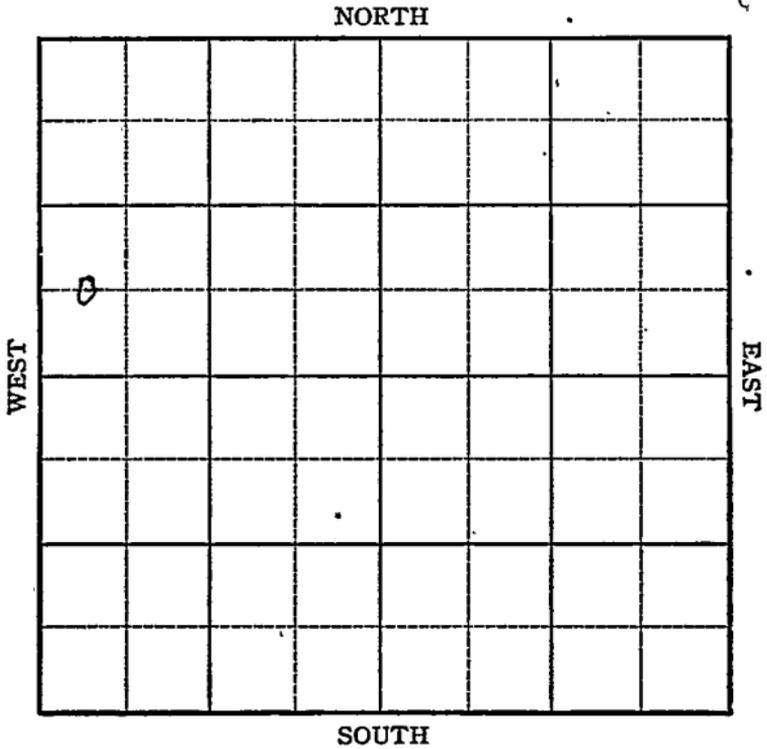

Sec. 16 Twp. 31 R. 14-W

Well No. #1, Skinner Farm

H & T Drilling Company

Skinner


_____ Ft. from N. Line

660' Ft. from S. Line

_____ Ft. from E. Line

330' Ft. from W. Line

C W L SW NW

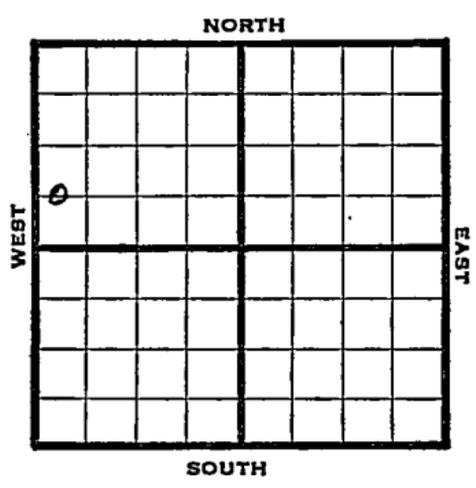

1946 1641 REPORT

- 10/2 Location.
- 10/8 13" @ 135'
Drlg 890'
- 10/15 1250 Run 8"
- 10/22 8" @ 856
Drlg 3125'
- 10/29 Drlg 4090'
- 11/6 Mag 4347'
5" @ 4 348'
TD 4351, RUST
- 11/12 " "
- 11/20 " "
- 11/27 " "
- 12/3 TD 4355'
- 12/10 fsg
- 12/17 TD 4361-3000 acid
- 1947
- 1/4 TD 4301-3000 acid
- 1/8 TD 4382-1000 acid
1 1/2 M Gas
PB 4350 WOC
- 1/15 " " "
- 1/21 " " "
- 1/30 " " "

OVER

2/5 TD 4382-1
1000 Acid
1½ Mill gas
PB 4350
WDC

2/12 " "

2/19 " "

2/26 " "

3/5 Wap 4347
5" @ 4348½
12500 Acid
9 M Gas
1100# R Pr
TD 4382'

COMPLETED

KANSAS Kansas Pool Name Skinner

Map No. 93 Sec. 16 Twp. 31 R. 14W

Well No. 1 Skinner

H & T Drlg. Company

FIRST REPORT

Contractor

C W L SW NW


SECTION PLAT

 Ft. from N. Line

660 Ft. from S. Line

 Ft. from E. Line

330 Ft. from W. Line

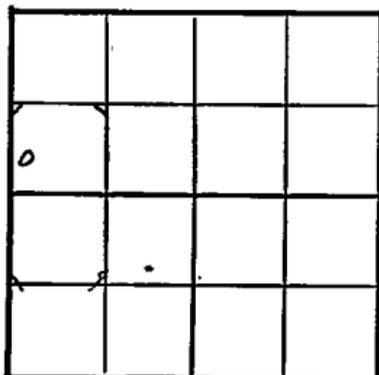

Barber County

Location X

Rig up

Drilling and Remarks:

RECORD

Cased in., ft.

Sand

Gas

Oil

Total Depth

PRODUCTION

1st 24 hrs. Nat.

1st 24 hrs. after shot

Gas Cu. Ft.

Dry Hole

Abandoned

Date

OCT 2 1946 19

S. J. LEWIS

Scout

Misc. Small Maps

Cards Sarah

Tracing ML

France Map

Scarborough Map

Pierce Map

Geological Dept.

Pierce Plat Book

KANSAS
Kansas

Skinner

Map No. 93 Sec. 16 Twp. 31 R. 14Well No. 1 Skinner

H. & T. Drlg.

Compa

**ABANDONED
COMPLETE**

Contract

C W L SW NW

E1.1641

SECTION PLAT

0			

_____ Ft. from N. Line

660 Ft. from S. Line

_____ Ft. from E. Line

330 Ft. from W. Line

Barber County

Location _____

Rig up _____

Drilling and Remarks:

Magno ke to 4347
5" R 43 48 1/2
12500 cu ft
9M Gas

*1100 * R 1/2*

RECORD

Cased _____ in., _____ ft.

Sand _____

Gas _____

Oil _____

Total Depth 14382

PRODUCTION

1st 24 hrs. Nat. _____

1st 24 hrs. after shot _____

Gas _____ Cu. Ft.

Dry Hole _____

Abandoned _____

Date

MAR 5 1947 19

S. J. LEWIS

Scout

195

P.L. 273

- Misc. Small Maps
- Cards DLG
- Tracing DLG
- France Map DLG
- Scarborough Map DLG
- Pièrcè Map DLG
- Geological Dept. DLG
- Pierce Plat Book