


Section 16 Township 31 Range 32 W

Well No. # 1 Davis (C)

Company Cities Service Oil Co.

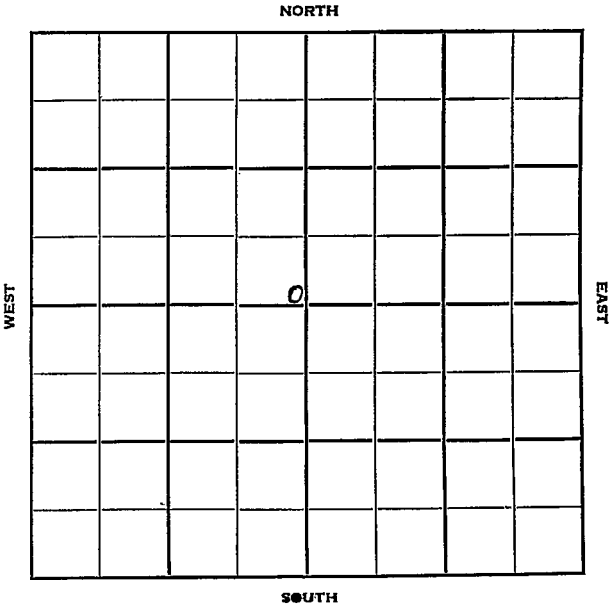

Seward

KANSAS

Sec. 16 Twp. 31 R. 32 W ☒

Well No. # I Davis (C) Farm

Cities Service Oil Co. Company

Contractor


Ft. from N. Line

100 Ft. from S. Line

100 Ft. from E. Line

Ft. from W. Line

SE NW

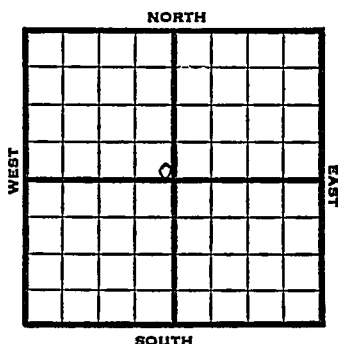

1951

Elev. 2864' REPORT

7/11

Location

10/24

Spud 7-11-51

Gas well TD 2745' 8" @ 579'

Her. 2591' Kr. 2621' Win. 2696'


5" @ 2744' TD 2745' 70/2700-14

30/2676-82 150/2646-64

30/2630-36 20/2620-24 14000 A

Comp. 6,850,000 gas

COMPLETED

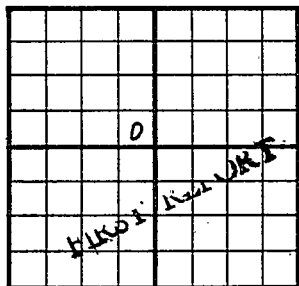County Seward State KansasSec. 16 (Blk.) 31 (Sur.) 32W Map No. (Twp.)Operator Cities Service Oil Co.Well No. 1 Farm Davis (C)Elev. Location SE NW100 Ft. From S Line NW100 Ft. From E Line Quarter1st. Report JUL 11 1951

Completion

Remarks

Spudding Date

Drlg. Data

Location


J. E. TYRA

County Seward State Kansas
 Sec. 16 (Blk. 31 (Sur. 32W Map No. 32W)

Operator Cities Service

Well No. 1 Farm Davis "C"

Elev. 2864 Location SE NW

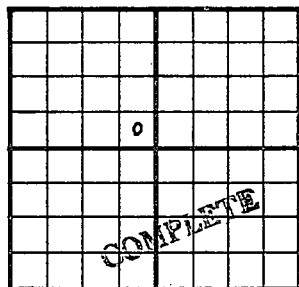

100 Ft. From S Line NW

100 Ft. From E Line Quarter

Ist. Report

Completion OCT 24 1951

Remarks

Spudding Date 7-11-51

Drig. Data Gas well TD 2745

8" @ 579 Her. 2591 Kri. 2621

Win. 2696 5" @ 2744 TD 2745

70/ 2700-14 30/ 2676-82 150/ 2646-64

30/ 2630-36 20/ 2620-24 14000 A

Comp. 6,850,000 gas

J. E. TYRA