


Section 16 Township 31 Range 33W

Well No. #1 Toland

Company Stanolind

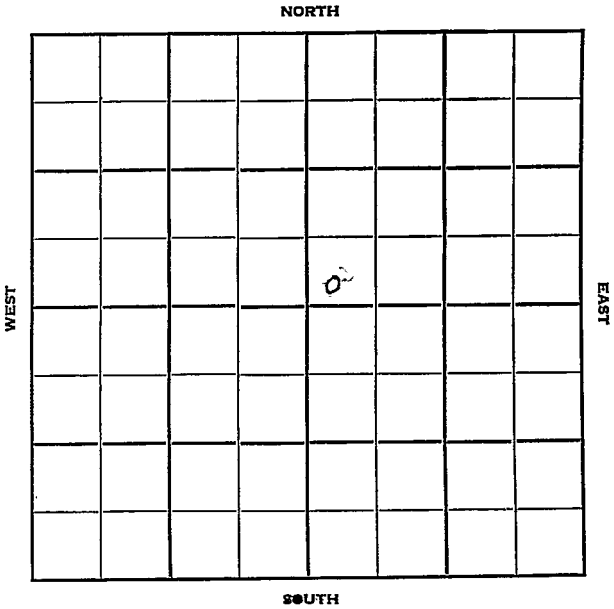

Seward
31

KANSAS 33W
R.

Sec. 16 Twp.

Well No. #1 Tolard Farm

Stanolind Company

Hugoton Pool Contractor


Ft. from N. Line

150' Ft. from S. Line

Ft. from E. Line

150' Ft. from W. Line

SW NE

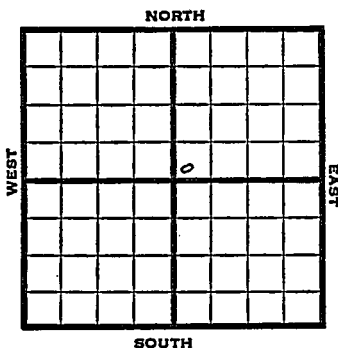

1951

Elev. - REPORT

6/6

Location

7/11

Spud 6-22-51 Gas well TD 2750'
 10" @ 672 5" @ 2730 TD 2750'
 Hol. 2573' Her 2605' Krider 2645'
 Win. 2687' Ft. Riley 2730'
 108/2690-2709 48/2643-51
 36/2656-62 114/2606-30
 24,000 A
 Comp. 9,600,000 gas

COMPLETED

