Sumner


KANSAS

SECTION 16 TOWNSHIP 31 RANGE 2W

WELL NO. #1 White

COMPANY T.L. Ferrier

NORTH SE SE SE

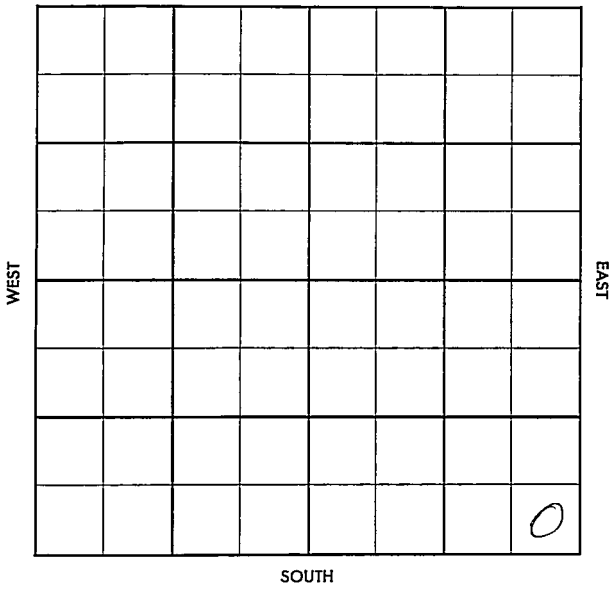

FORM 504-3 SUNRAY

FORM 513 SUNRAY

County Sumner Elev.

Sec. 16 Twp. 31 Rge. 2W

Company T. E. Ferrier

Farm Name White No. 1

TOPS	DEPTH	LOG	DATUM
Anh.			
Tp.			
H.			
Tr.			
Dg.			
Bl.			
L.			
K.C.			
B.K.C.			
Ce.			
C.			
M.			
M.			
K.			
Mz.			
Mc.			
V.			
S.			
S.			
A			
R.			
P€.			
G.			
T.D.			

Loc. in Sec. SE SE SE

Geol.

Contr. White & Ellis

Pool Beatie

FIRST REPORT

FEB 13 '57

0

Date Comm.

Cellar & Pits

2 1/8

Co.

Lse.

No.

Sec.

T.

R.

FORM 513 SUNRAY

County Sumner Elev. 1261 KB 1258

Sec. 16 Twp. 31 Rge. 2W

Company T. L. Ferrier

Farm Name White No. 1

TOPS	DEPTH	LOG	DATUM
Anh.			
Tp. Hask	2783		
H.			
Tr.			
Dg.			
Bl.			
L. →	3092		
K.C.			
B.K.C.			
Ce.			
C.			
M.	3746		
M.			
K.	4124		
Mz.			
Mo.			
V.			
S.	4188		
S.			
A			
R.			
Pe.			
G.			
T.D.	4191		

Loc. in Sec. SE SE SE

Geol. J. P. McKee

Contr. White & Ellis

Pool #4 Beatie

COMPLETE APR 24 57

Date Comm.

Cellar & Pits [illegible] spd 2-14-57

8 5/8 @ 228/175 Ø 2163 [illegible] X

Hask 2783 Lsg 3092 DST 3226-36

75" rec 320' MCSW BHP 1240/15"

Miss. 3746 Ø 3790' 57 Pipe

set. [illegible] DST 4188-91 (60) rec (24)

rec 30' HOCM 300' OCM, BHP 1480

RTD 4191 5½" 4188' WOCT

CO 4191 FU 2300' OC/2hrs NW

MD 2-57

FORM 513-1 SUNRAY

Flow 28 Bo 1 hr. Flwd
101 Bo in 2 hrs. MAR 27 ? APR 3 '57
P. 97 Bo + 1/2 Bw in 12
hrs. APR 10 '57 APR 17 '57 APR 24 '57 Ph P.
155 Bopd + 3/10 % wtr
grav 48°

16-31-2W SE SE SE