


Section 16 Township 31 Range 9W

Well No. #1 Donald Muir G.U.

Company The Texas Co.

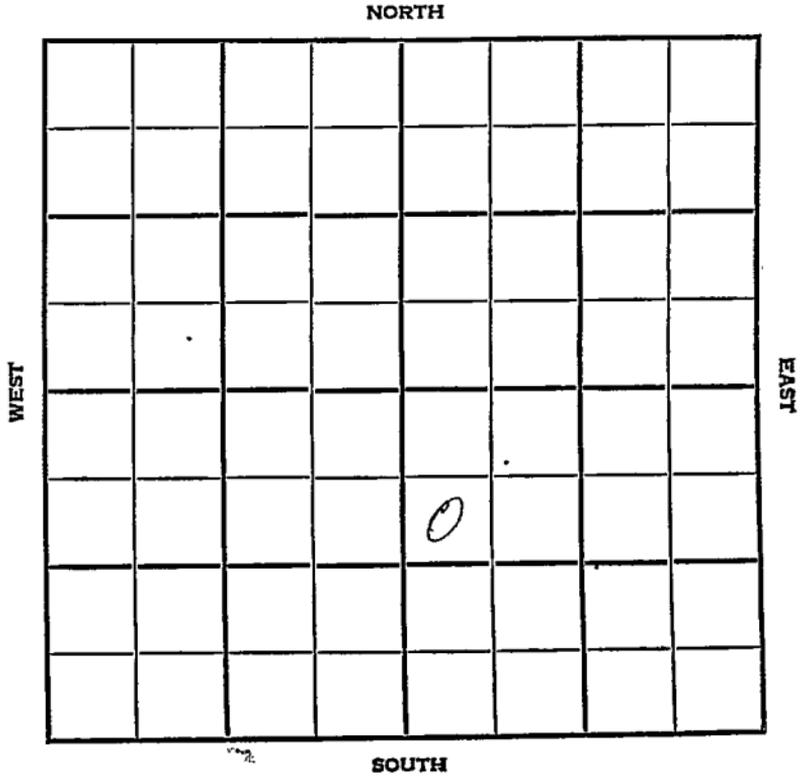

County Hamber Elev. 1700 DP
 Sec. 16 Twp. 31 Rge. 9W
 Company The Texas Co.
 Farm Name Donala Muir G.L. No. 1

TOPS	DEPTH	LOG	DATUM	Loc. in Sec.						
Anh.				St NW SE						
Ip.										
H.										
Tr.										
Dg. <u>sd</u>	<u>3607</u>	<u>3627</u>								
Bl.										
L.	<u>3739</u>	<u>3743</u>								
K.C.				Geol.						
B.K.C.		<u>4257</u>		Concr.						
C.				Stickle Drlg.						
C. <u>Marm</u>		<u>4292</u>								
M.		<u>4457</u>		Pool						
M.				Spivey-Grabs						
K.										
Mz.										
Mo.										
V.										
S.										
S.										
A.										
R.										
PE.										
G.										
T.D.	<u>4578</u>			<table border="1"> <tr> <td colspan="2">COMPLETE</td> </tr> <tr> <td></td> <td>o</td> </tr> <tr> <td>JAN 9 '57</td> <td></td> </tr> </table>	COMPLETE			o	JAN 9 '57	
COMPLETE										
	o									
JAN 9 '57										

Date Comm. 12-1-56

10" @ 338 w/350, drlg. 1750 DEC 12 '56 # 3888
DEC 19 '56 DST 4456-75 1hr G/13"
9a 35 MCF/45" no rec
1230/36" 7" @ 4517/200 DEC 25 '56
C0 4509 9/4502-05 tst dry
30/4488-98 tst dry 1/2 TB dry
tst 160 + 36 Acid wt PH S.D.
JAN 2 '57 tst 2 D0 + 14 BW FRAC
tst 800 MCFG 54/4457-75

Plg PFS. 4502-05 & 4488-98

w/ temp plug FRAC PFS

4457-75 tst 1,100 MCFG

S.I. FOR 72-20

JAN 2 1977

72-20 9a 1,558

MCFG PD SIP 1460#