


18-31-17W

State Geological Survey
WICHITA BRANCH

KANSAS CORPORATION COMMISSION
WELL RECORD

(Mail to Kansas Geological Survey, 4150 Monroe Street, Wichita, Kansas 67209)

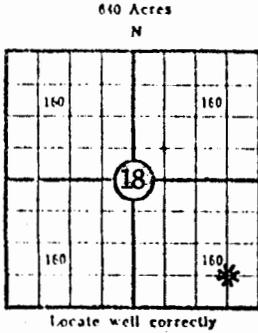

Lease Name: Huff Well No. 1
 Well Located: C SE SE
SEC 18 TWP 31S RGE 17W
 Operator: Sidwell Oil and Gas, Inc.
 Address: P. O. Box 2475, Pampa, Texas 79065
 Elevation: Ground 2032' D.F. 2034' K.B. 2037'
 Type Well: (Oil, gas, dry hole) =Gas

Drilling Commenced: 10-28- 1971 Drilling Completed: 11-8- 1971
 Well Completed: 12- 7- 1971 Total Depth 4989'
 Initial Production: Shut in

Casing Record

Size: 8 5/8" Set at 521' Size: _____ Set at _____
 Size: 4 1/2" Set at 4,992' Size: _____ Set at _____

Liner Record

Size: _____ Set from _____ To _____

Cementing

Casing Size	Sacks	Type Cement and Additives
<u>8 5/8"</u>	<u>225</u>	<u>50-50 Posmix, 4% gel, 3% cc</u>
_____	<u>200</u>	<u>Common, 3% cc</u>
_____	_____	_____

Perforations

Formation	Perforated Interval and Number Shots
<u>Mississippian</u>	<u>4974-4982' - 2 shots per foot</u>
<u>Mississippian</u>	<u>4952-4962' - 2 shots per foot</u>
_____	_____
_____	_____

Electric Log Run (Show type log and depths covered)

Welex radioactivity 0-4968'
Welex Gamma-Collar Perforation 4000' to 4976'
Welex Micro-seismogram log-cased hole 4978' to 4200'

(Fill in formation and related information on reverse side)

LOGS AVAILABLE AT THE STATE GEOLOGICAL SURVEY

18-31-17w


FORMATION, TESTING AND COMPLETION RECORD

Show Drill Stem Tests,
Well Stimulation and
Production Tests

Formation	Top	Bottom	
Heebner	4139(-2102)		
Brown Lime	4310(-2273)		
Lansing	4330(-2293)		
Marmaton	4803(-2766)		
Cherokee	4895(-2853)		
Mississippian	4948(-2911)		
			DST #1 - 4950-4989 gauged 6,640 Mcf
			15 minute initial flow pressure 1005#
			Final Flow pressure 1153#
			45 minute ISIP 1660#
			105 minute FSIP 1660#
			Stabilized @ 1664#

WELL LOG

18-31-17W

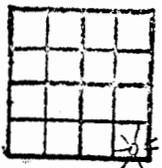

Sec. 18 T. 31S R. 17W

Loc. C SE SE


County Comanche

Casing 8 5/8"

Production 4 1/2"

16,000,000

EL 2037

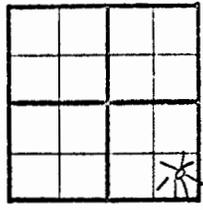

Company Sidwell Oil and Gas Company

Contractor Leben Drilling, Inc.

Farm Huff #1

Total Depth 4989'

Commenced October 29, 1971

Completed November 8, 1971

Figures Indicate Bottom of Formations

0'	-	440'	sand - red bed
440'	-	964'	shale
964'	-	980'	anhy
980'	-	1920'	shale
1920'	-	2240'	shale & lime
2240'	-	2835'	lime & shale
2835'	-	3987'	shale & lime
3987'	-	4120'	lime & shale
4120'	-	4280'	shale & lime
4280'	-	4710'	lime & shale
4710'	-	4815'	lime
4815'	-	4912'	lime & chert
4912'	-	4989'	lime & shale w/chert strks.

LOG TOPS	DEPTH
HEEB	4139
BR LM	4310
LANS	4330
MARM	4803
CHER	4895
MISS	4948
LTD	4976
RTD	4989

State of Oklahoma

County of Oklahoma

SS