


KANSAS Barber County

Section 17 Township 31 Range 13W

Well No. #1 Yoke

Company Pryor & Lockhart

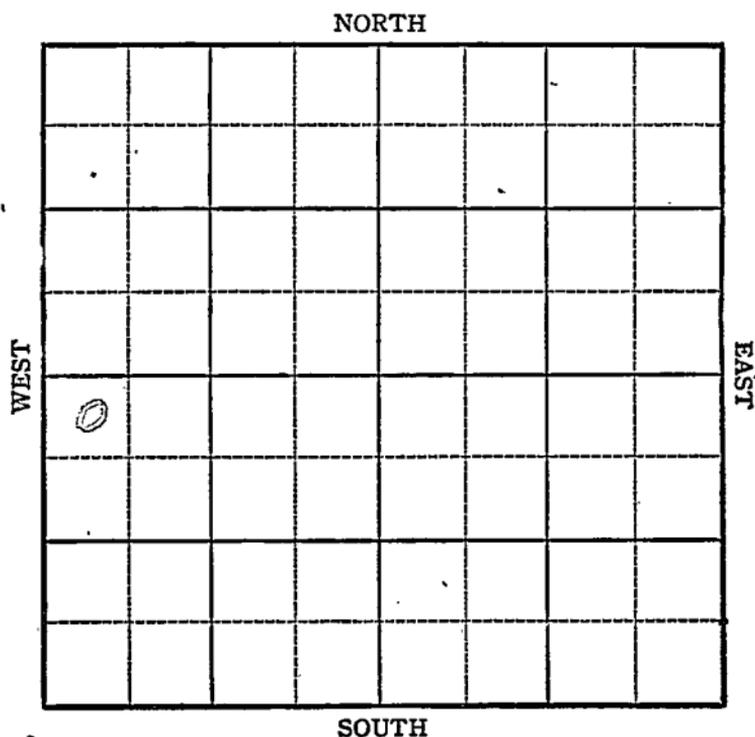

KANSAS

Barber County

Sec. 17 Twp. 31 R. 13W

Well No. #1 Yoke Farm

Pryor & Lockhart Company


Gant

330 Ft. from N. Line

_____ Ft. from S. Line

_____ Ft. from E. Line

330 Ft. from W. Line

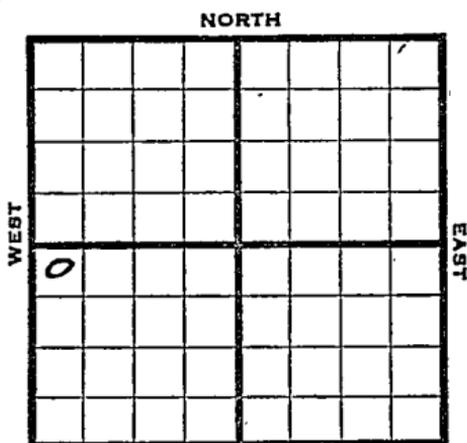

NW-SW *Elev. 1644*

1944

R E P O R T

10/4 Location

10/11 Drk.

10/18 13" @ 220 WOC,

10/25 Anhy 552 .

Drlg. 2557

11/1 Drlg. 3620

11/8 Lans 3769

Miss 4254

Drlg. 4278

11/15 Kind 4329

Viola 4427

Simp Sd 4560

Arb 4629

Miss 4259 corrected

TD 4700

ABANDONED

KANSAS
KANSAS

Pool Name Gant

Map No. 98 Sec. 17 Twp. 31 R. 13W

Well No. 1 Yoke

Pryor & Lockhart Company

FIRST REPORT Contractor

NW SW


SECTION PLAT

330 Ft. from N. Line

_____ Ft. from S. Line

_____ Ft. from E. Line

330 Ft. from W. Line

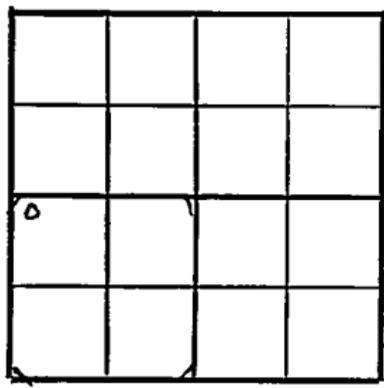

Barber

Location X

Rig up _____

Drilling and Remarks:

RECORD

Cased _____ in., _____ ft.

Sand _____

Gas _____

Oil _____

Total Depth _____

PRODUCTION

1st 24 hrs. Nat. _____

1st 24 hrs. after shot _____

Gas _____ Cu. Ft.

Dry Hole _____

Abandoned _____

Date

OCT 4 1944 19

S. J. LEWIS Scout

Misc Small Maps _____
Cards _____
Tracing _____
France Map _____
Scarborough Map _____
Pierce Map _____
Geological Dept. _____
Pierce Dept. _____

Reid

Letty

Reid

Pool Name GantMap No. 93 Sec. 17 Twp. 31 R. 13WWell No. 1 YokePryor & Lockhart

Company

ABANDONED

Contractor

NW SW

SECTION PLAT

330 Ft. from N. Line

_____ Ft. from S. Line

_____ Ft. from E. Line

330 Ft. from W. Line

o			

Barber County

Location _____

Rig up _____

Drilling and Remarks:

*Kind 4829**Viola 4427**Simp. Sol. 4560**Co. 4629**Miss 4257. Correct*

RECORD

Cased _____ in., _____ ft.

Sand _____

Gas _____

Oil _____

Total Depth 4700

PRODUCTION

1st 24 hrs. Nat. _____

1st 24 hrs. after shot _____

Gas _____ Cu. Ft.

Dry Hole _____

Abandoned _____

Date

NOV 15 1944 19

S. J. LEWIS

Scout

2125 F

5 100 7

2001 100 1

Misc. Small Maps	<i>Heid</i>
Cards	<i>DA</i>
Tracing	<i>ML</i>
France Map	<i>✓</i>
Scarborough Map	<i>Heid</i>
Pierce Map	<i>✓</i>
Geological Dept.
Pierce Plat Book