

KANSAS

FORM 51 5M 1-42 PETROL

Barber

Section 17 Township 31 Range 14-W

Well No. #1 Skinner

Company J. M. Huber Corp.

9									

NORTH

WEST

EAST


SOUTH

KANSAS

Barber

Sec. 17 Twp. 31 R. 14-WWell No. #1 Skinner FarmJ. M. Huber Corp. Company660 Ft. from N. Line Ft. from S. Line Ft. from E. Line330 Ft. from W. Line

Elev. 1653

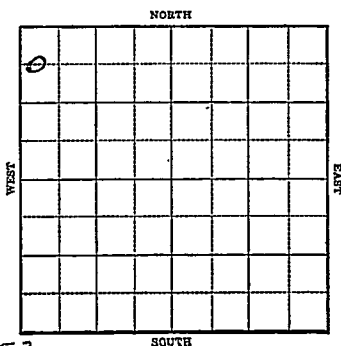

1944

R E P O R T

1/5 Location.

1-12 "

1/19 Drlg. 400'

1/26 10" @ 283
Drlg. 13502/2 8" @ 1115
Drlg. 1470

2/8 Drlg. 2805

2/15 Drlg. 3885

2/23 Lans 3786
BKC 4162
Cong 4285
Viola 4351
TD 44043/1 Simp sd 4494
Arb 4609?
TD 4627 to take DST3/8 TD 4628
5" @ 4595
Rust

OVER

1944

3/16 Plug 4487-64 shots
4416-30

No Shows

3/22 " "

3/29 40 shots 4356-74
7nm. gas 1000acid 51 M. Gas

4/5 " " "

4 /12 5" @ 4595
Viola 4351
Arb 4609
TD 4628
40 shots 4356-74
1000 acid
34,567,000 gas
1467 # RP

COMPLETED

KANSAS
Map No. 73 Sec. 17 Twp. 31 R. 14W

Well No. 1 Skinner

J.M. Huber Corp. Company

COMPLETED

Contractor

C W L NW NW

SECTION PLAT

660

Ft. from N. Line

Ft. from S. Line

Ft. from E. Line

330

Ft. from W. Line

o			

Skinner Pool

Location

Rig up

Drilling and Remarks:

Vidla 4351

CR 44609

5" @ 4595

40 shots 4356-74

10000 @ 200

84,567,000 Gas.

1467 R P₂

RECORD

Cased _____ in., _____ ft.

Sand _____

Gas _____

Oil _____

Total Depth 4625

PRODUCTION

1st 24 hrs. Nat. _____

1st 24 hrs. after shot _____

Gas _____ Cu. Ft.

Dry Hole _____

Abandoned _____

Date

APR 12 1944

19

S. J. LEWIS

Scout

Misc. Small Maps

Card

Tracing

France Map

Scarborough Map

Moody Map

Geological Dept.

Plot Book

KANSAS

Map No. 72 Sec. 17 Twp. 31 R. 14WWell No. 1 SkinnerJ. M. Huber Corp. Company

FIRST REPORT

Contractor

C W L NW NW

660 Ft. from N. Line

Ft. from S. Line

Ft. from E. Line

330 Ft. from W. Line

SECTION PLAT

0			

TURKEY CREEK POOL

Location X

Rig up

Drilling and Remarks:

RECORD

Cased _____ in., _____ ft.

Sand _____

Gas _____

Oil _____

Total Depth _____

PRODUCTION

1st 24 hrs. Nat. _____

1st 24 hrs. after shot _____

Gas _____ Cu. Ft.

Dry Hole _____

Abandoned _____

Date

JAN 5 1944 19 _____ S. J. LEWIS Scout

Omia
Madge
MEL



ological Dept
only Plant Book