



Barber

KANSAS

Sec. 17 Twp. 31 R. 14W

Well No. #3 Skinner Farm \_\_\_\_\_

Huber Company


Skinner Pool

990' Ft. from N. Line

\_\_\_\_\_ Ft. from S. Line

\_\_\_\_\_ Ft. from E. Line

990' Ft. from W. Line

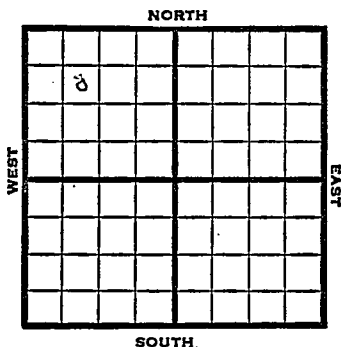

SE NW NW

SOUTH.

1948 Elev 1649' REPORT

12/29 Location

1/5 16" @ 90'  
10" @ 800'

1/12 Drlg 3640

I/19 Drlg. 4060'

1/26 Viola 4359-87'

TD 4387'

5" @ 4377'

2/2 200 acid

Swb 1 1/2 bbls oil PH

2/9 4398'

Flow 4 bbls oil PH

2/16 2000 acid

Flow 64 bbls oil - 5 hrs.

2/23 TD 4398'

Viola 4359'

5" @ 4377'

2000 acid

Flow 264 oil / 4% W Pot

43° Gr.

Comp

**COMPLETED**

Map No. \_\_\_\_\_ Sec. 17 Twp. 31 R. 14W

Well No. 3 Skinner

Huber Company

**FIRST REPORT** Contractor

SE NW NW


**SECTION PLAT**

990 Ft. from N. Line

\_\_\_\_\_ Ft. from S. Line

\_\_\_\_\_ Ft. from E. Line

990 Ft. from W. Line

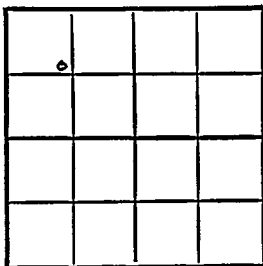

Barber County

Location X

Rig up \_\_\_\_\_

Drilling and Remarks:

**RECORD**

Cased \_\_\_\_\_ in., \_\_\_\_\_ ft.

Sand \_\_\_\_\_

Gas \_\_\_\_\_

Oil \_\_\_\_\_

Total Depth \_\_\_\_\_

**PRODUCTION**

1st 24 hrs. Nat. \_\_\_\_\_

1st 24 hrs. after shot \_\_\_\_\_

Gas \_\_\_\_\_ Cu. Ft.

Dry Hole \_\_\_\_\_

Abandoned \_\_\_\_\_

Date

DEC 29 1948 19

S. J. LEWIS Scout

Kansas

Map No. K93 Sec. 17 Twp. 31 R. 14W

Well No. 3 Skinner

Huber Company

**COMPLETE**

Contractor

SE NW NW

*E 11649*

**SECTION PLAT**

990 Ft. from N. Line

\_\_\_\_\_ Ft. from S. Line

\_\_\_\_\_ Ft. from E. Line

990 Ft. from W. Line

o			

**Barber County**

Location \_\_\_\_\_

Rig up \_\_\_\_\_

Drilling and Remarks:

*Viola 4359*  
*5" C 4377*  
*2000 acid*  
*Flow 264 oil + 4 gas*  
*AD*  
*43.8 g*

**RECORD**

Cased \_\_\_\_\_ in., \_\_\_\_\_ ft.

Sand \_\_\_\_\_

Gas \_\_\_\_\_

Oil \_\_\_\_\_

Total Depth 4398

**PRODUCTION**

1st 24 hrs. Nat. \_\_\_\_\_

1st 24 hrs. after shot \_\_\_\_\_

Gas \_\_\_\_\_ Cu. Ft.

Dry Hole \_\_\_\_\_

Abandoned \_\_\_\_\_

Date

FEB 23 1949

S. J. LEWIS Scout